


T. 7 S., R. 1 W., W. M.

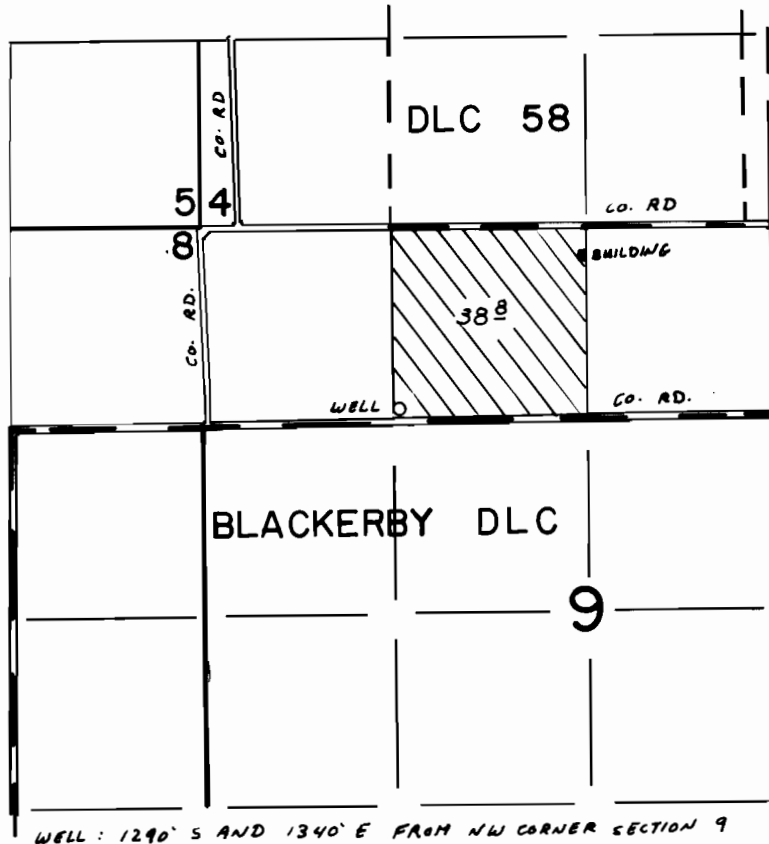

SCALE 1" = 1320'

FINAL PROOF SURVEY UNDER

Application No. G-11480 Permit No. G-10596

IN NAME OF

NORMA VON FLUE

Surveyed JUN 8 1988 by Z. SALEH