


T. 6 & 7 S., R. 1 W., W.M.

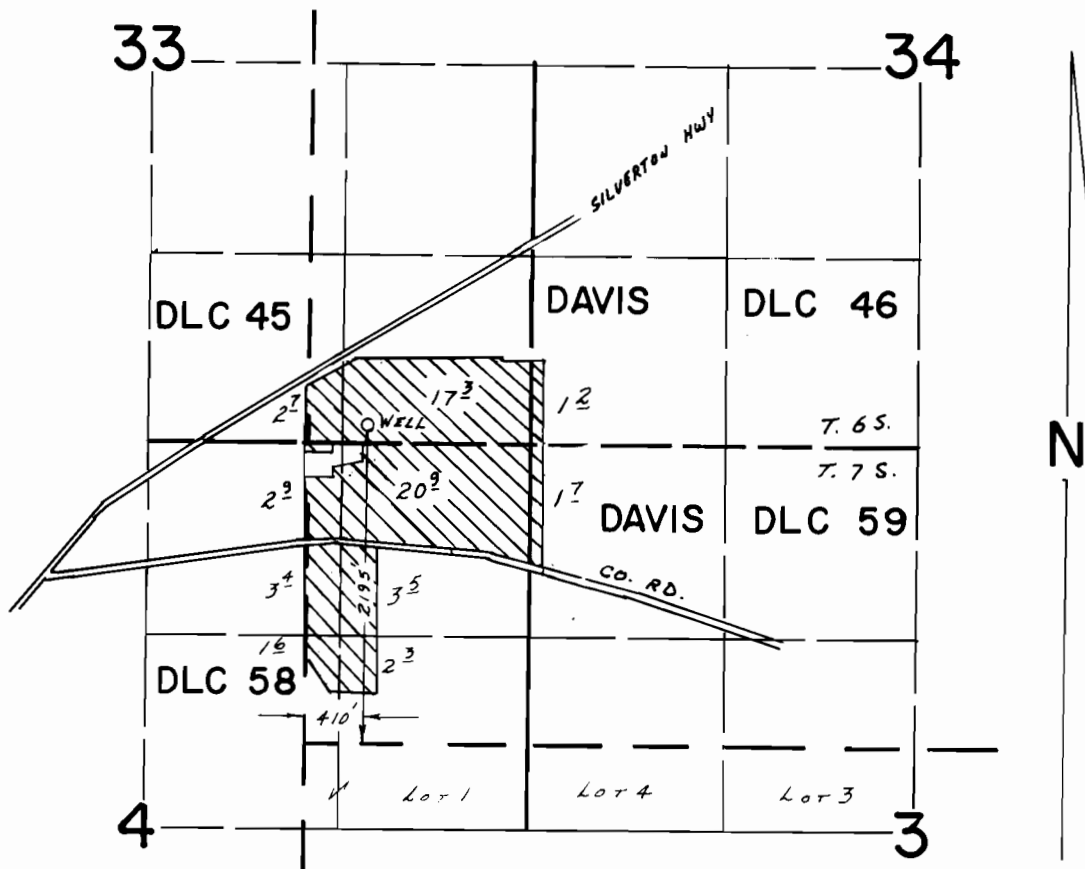

SCALE 1" = 1320'

FINAL PROOF SURVEY UNDER

Application No. **G-11595** Permit No. **G-10671**
IN NAME OF

COOLEYS GARDENS INC.

Surveyed **MAY 19 1988**, by **Z. SALEH**