


T.10S., R.38E., W.M.

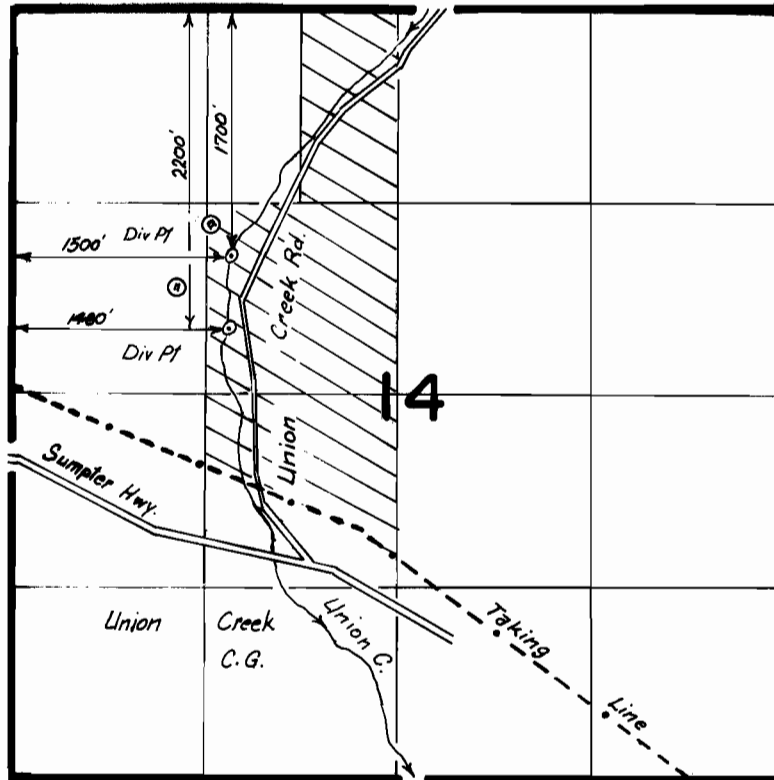

Scale: 1" = 1320'

FINAL PROOF SURVEY UNDER

⊙ Current mining

⊙ Future mining

Application No. **39413**.. Permit No. **29607**..
IN NAME OF

T.H.C. INC. dba: FLAGSTAFF MINES

Surveyed **7-6**..... 19**88**., by **Kenn Kemp**.....

PTS KK 12-9-88