


T.6 & 7 N., R.2W., W.M.

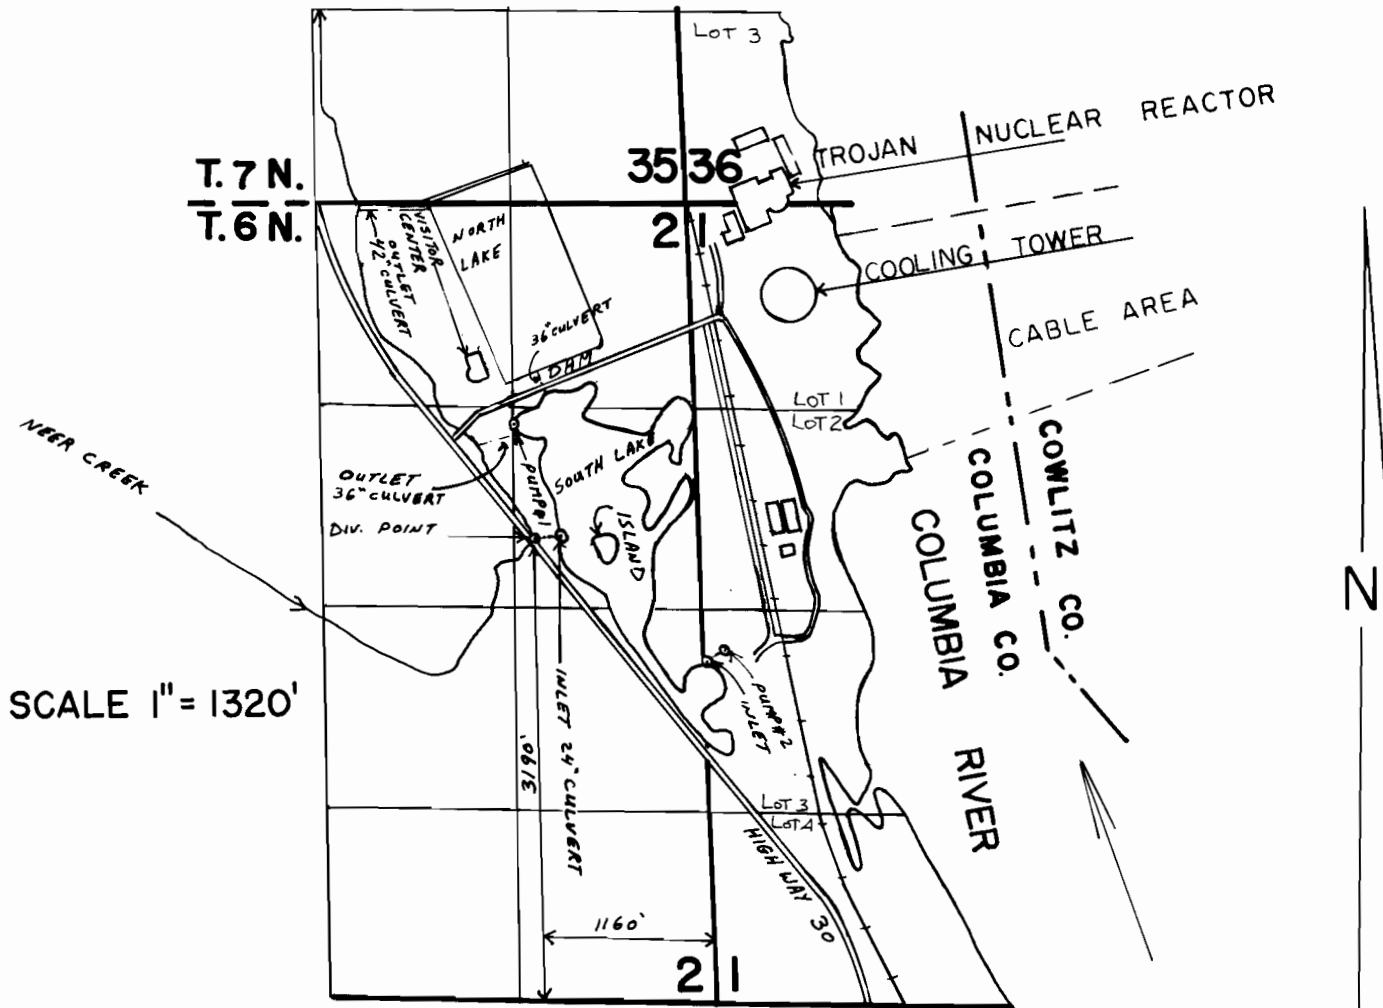

SCALE 1" = 1320'

FINAL PROOF SURVEY
UNDER

R-47344

R-5594

Application No. **47345** Permit No. **34941**

IN NAME OF

PORTLAND GENERAL ELECTRIC CO.

Surveyed **AUG. 24 1988** by **ZEIDAN F. SALEH**