




T. 27 S., R. 14 W., W.M.

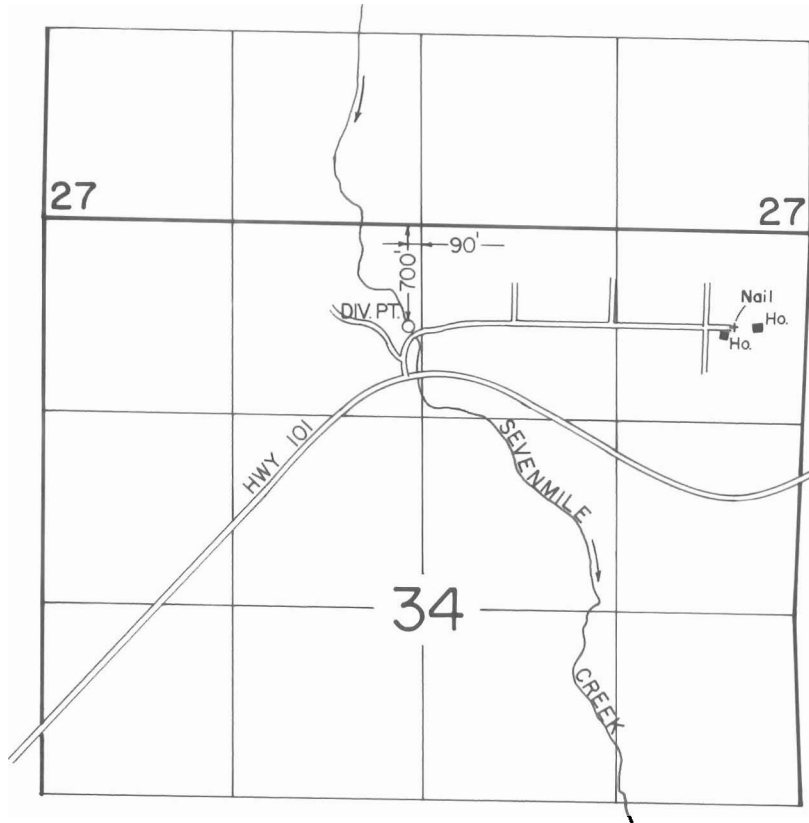

SCALE: 1" = 1320'

FINAL PROOF SURVEY
UNDER

Application No. 49606. Permit No. 36243.....
IN NAME OF

HARRY ABEL.....

Surveyed SEPT. 22, 1988, by L. H. NUNN.....