


T3N, RIOW, WM

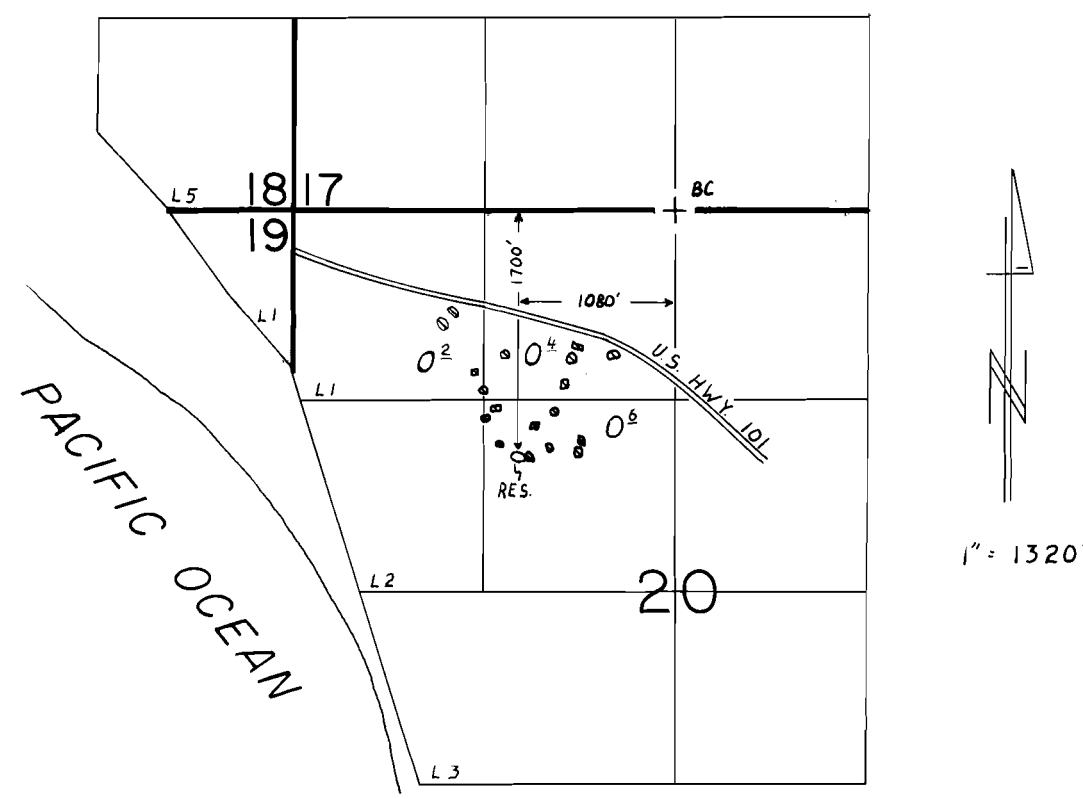

FINAL PROOF SURVEY UNDER

R-49966 R-6097
 Application No. 49967 Permit No. 37587
 IN NAME OF
 JOHN MEMERING
 MAY 21 84 P. R. PAGTER
 Surveyed JULY 6 1987, by T. M. WARREN