


# T.38S.R.14W.W.M.

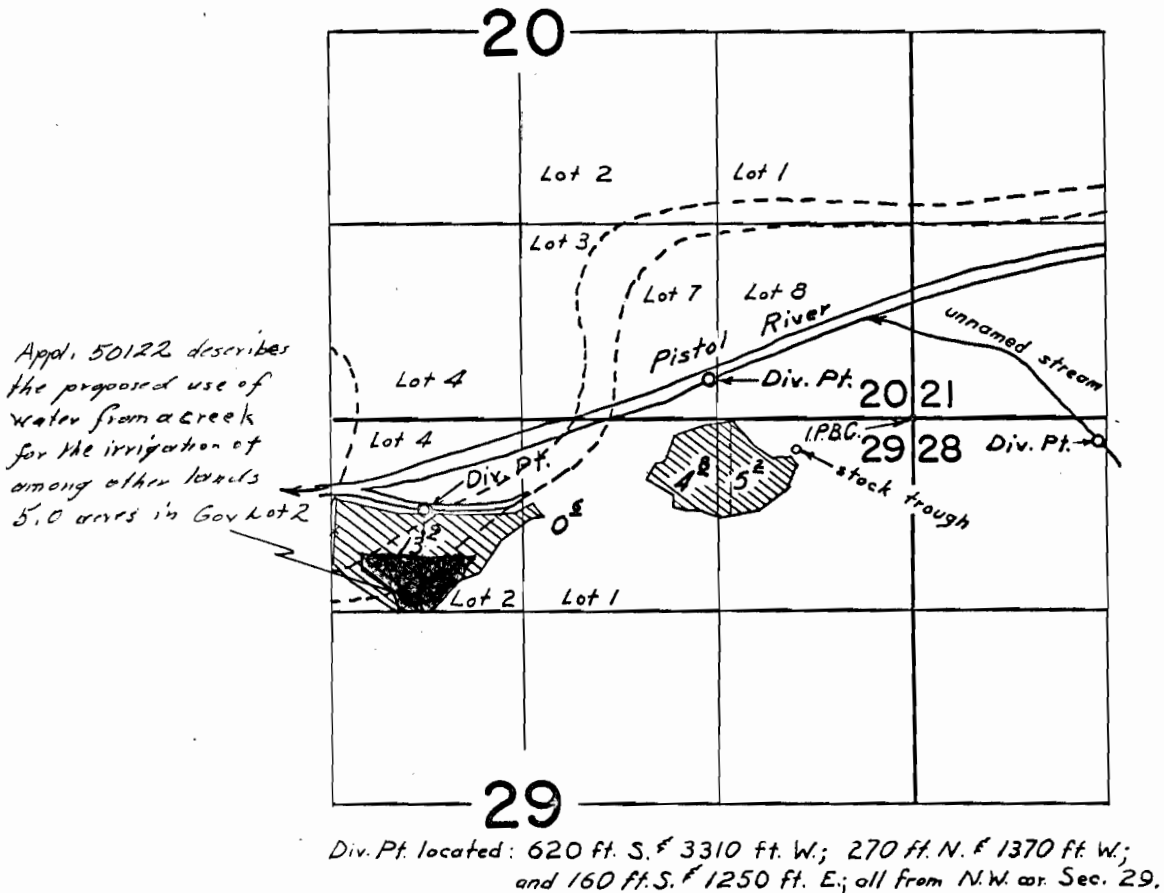

## FINAL PROOF SURVEY UNDER

Application No. 39800 Permit No. 29830  
IN NAME OF

HARVEY CROOK

Surveyed Aug. 27, 1969, by L. E. Gould