


T. 35 S., R. 5 W., W.M.

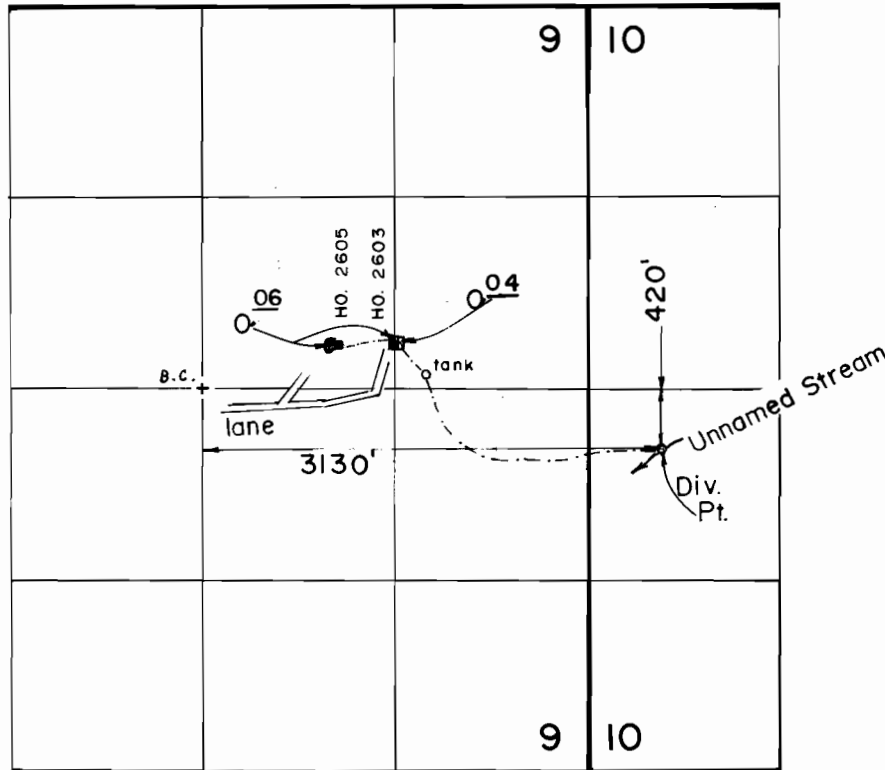

Scale: 1" = 1320'

FINAL PROOF SURVEY UNDER

Application No. **51381** Permit No. **38196**
IN NAME OF

STERLING FOREMAN & CHARLES CANGIOSE

Surveyed S.E.R. 17... 19.87., by B.S. JAMES...