


TIOS, R8W, WM

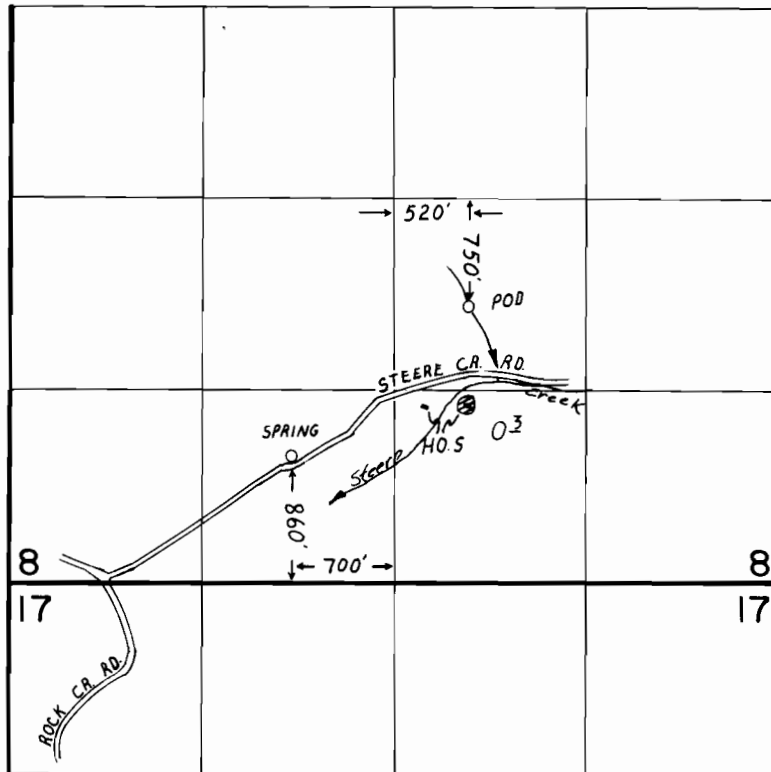

FINAL PROOF SURVEY UNDER

Application No. 51481... Permit No. 38857.....
IN NAME OF

.....MARY J. ROBB.....

Surveyed NOV....4... 1987., by J.M. WARREN...