


T. 26 S., R. 11 W., W.M.

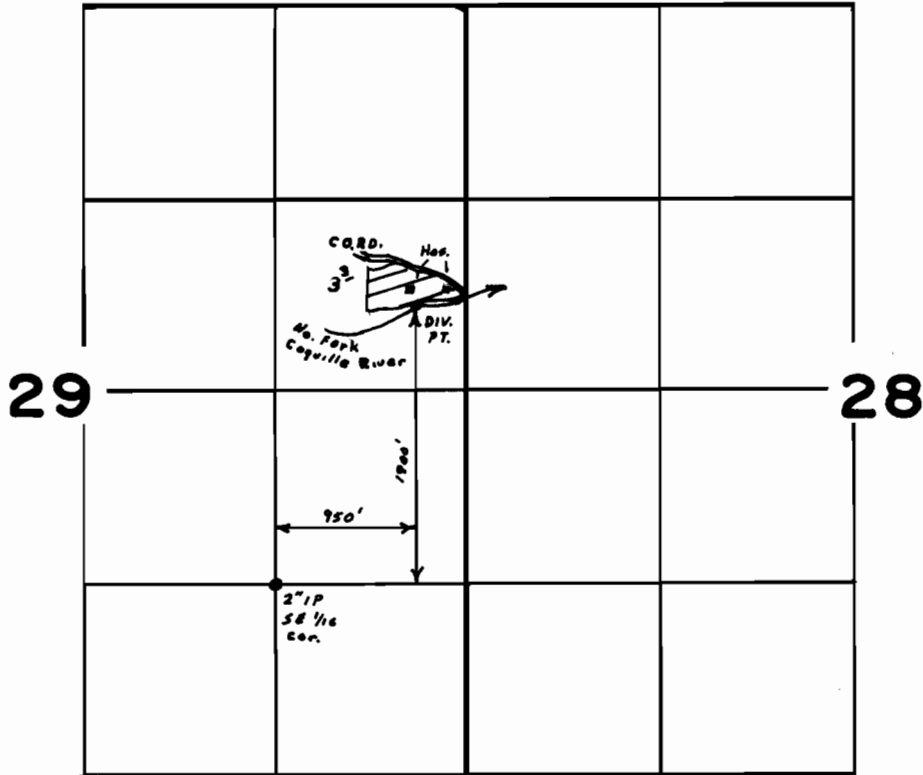

SCALE: 4" = 1 mile

FINAL PROOF SURVEY
UNDER

Application No. 51802... Permit No. 39140...
IN NAME OF

CARL & ROBERT AUER

Surveyed OCT. 10, 1979, by S. DONALDSON
Sept. 21, 1988 by S. JAMES