


T2S, R2E, WM

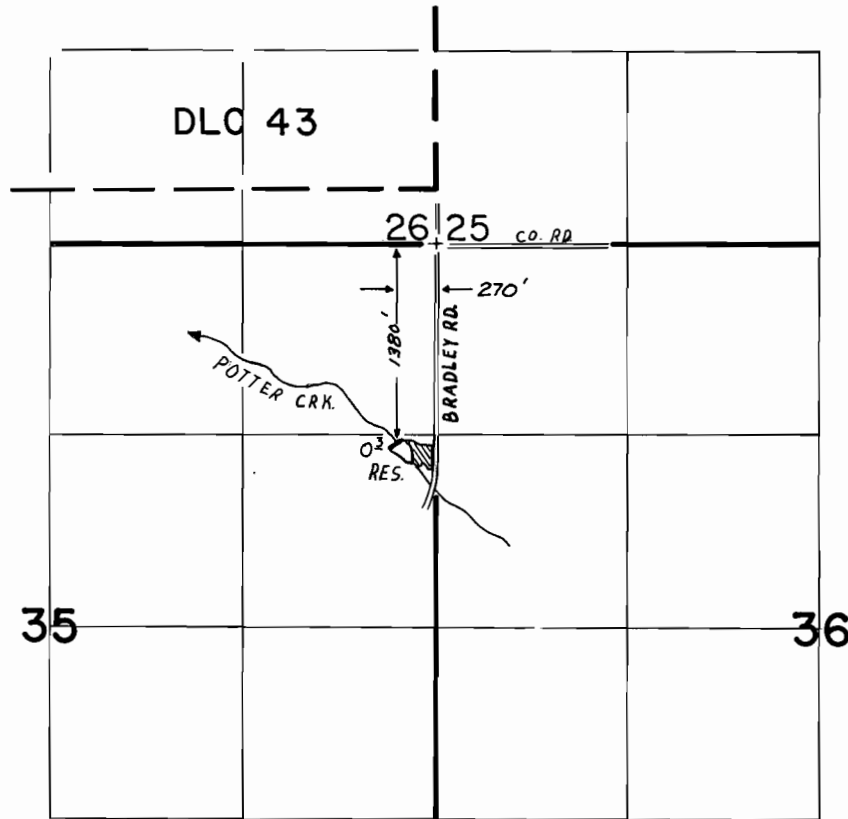

Scale: 1" = 1320'

FINAL PROOF SURVEY UNDER

R-5 2481 R-6376
 Application No. 52482 Permit No. 39801.....
 IN NAME OF

BETTY K. BARKLEY

Surveyed AUG. 29. 1986, by J.M. WARREN...