


T. 8S., R. 16 E., W.M.

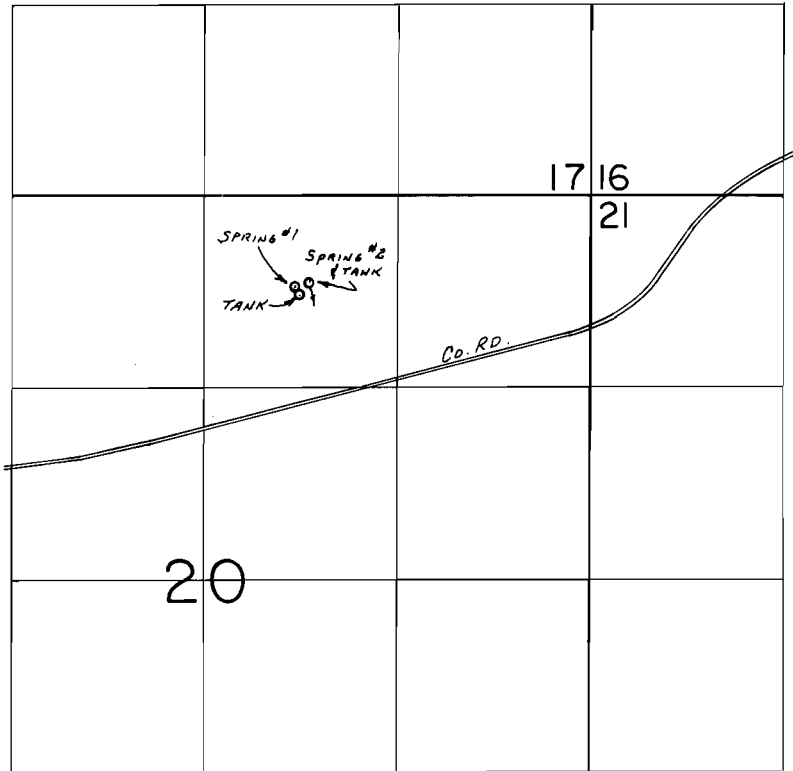

SPRINGS LOC.: #1- 620'S. & 620'E.; #2- 600'S. & 720'E.; BOTH FROM N 1/4 COR. SEC. 20.

SCALE: 1" = 1320'

FINAL PROOF SURVEY
UNDER

Application No. 54046.. Permit No. 40422.....
IN NAME OF

DONALD A. & ROBERTA E. LUCAS

Surveyed ..Aug. 10.. 1988., by B.W. BISHOP.....

12/7/88 BWB

41065-172-34