


# T. 40 S., R. 14 W., W. M.

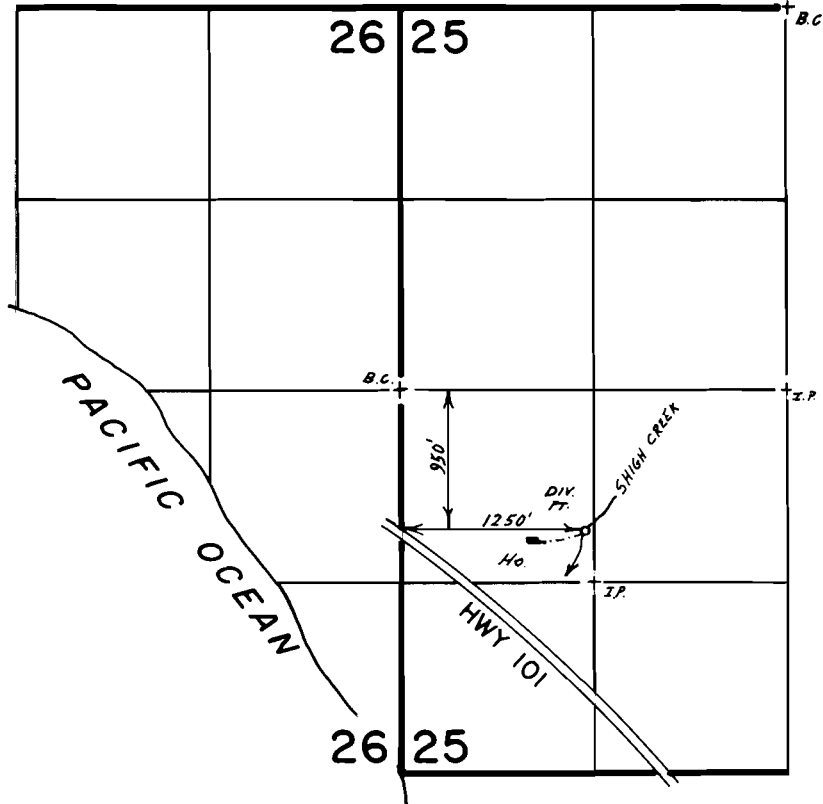

Scale 1" = 1320'

## FINAL PROOF SURVEY UNDER

Application No. ~~54448~~ Permit No. ~~41310~~.....  
IN NAME OF

...MAUDE.....LONGACRE.....

Surveyed Sept. 4, 1987, by J.M. SCHMORDE