


# T.14 S. R.6 W. W.M.

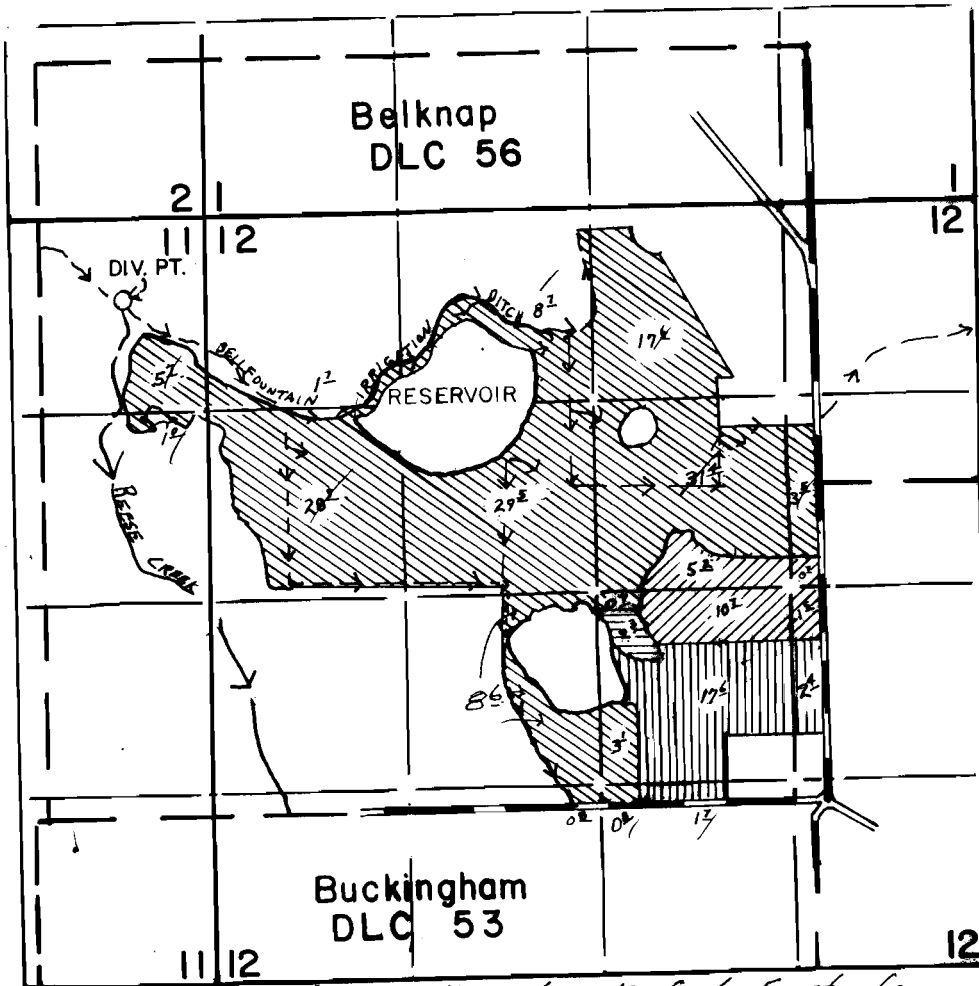

DIV. PT. LOC: 1640 feet South and 540 feet East from  
 NW Corner DLC 56.

## FINAL PROOF SURVEY UNDER

R-55308                      R- 7817  
 55309                        44089  
 Application No. 63059 Permit No. 46929

IN NAME OF

**HERMON NUSBAUM**

Surveyed June 24, 1983, by L. TOLL