


T. 36 S., R. 6 W., W.M.

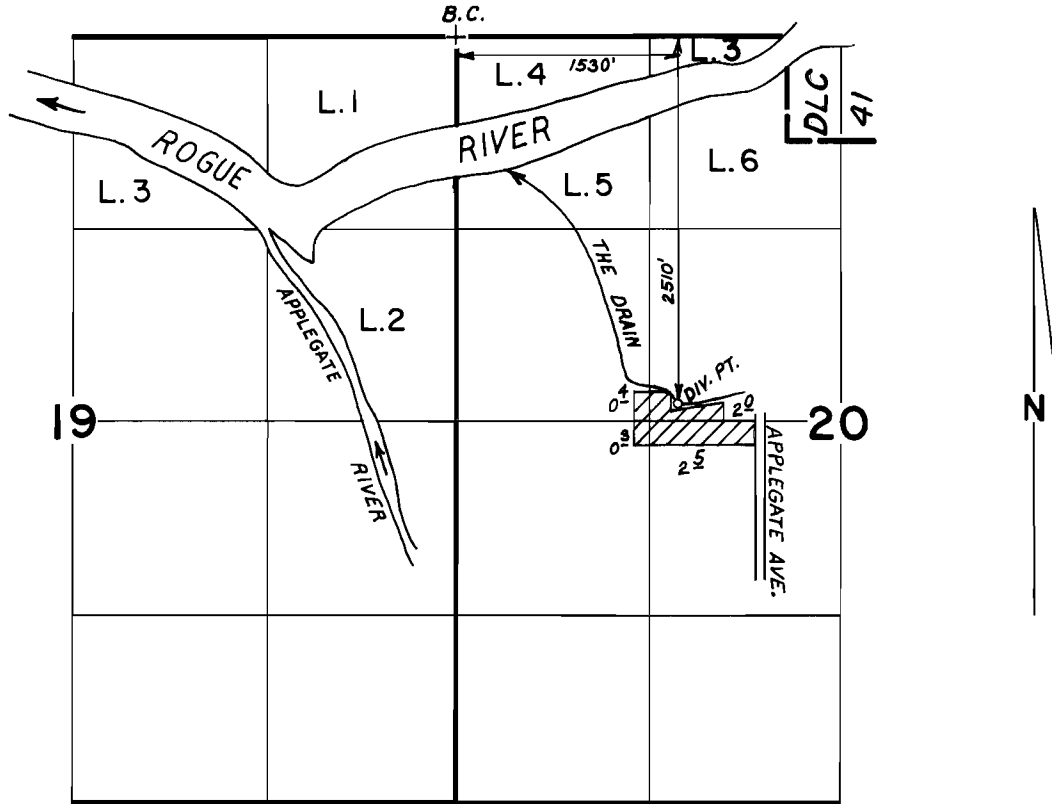

SCALE: 1"=1320'

FINAL PROOF SURVEY
UNDER

Application No. **57372** Permit No. **43465**
IN NAME OF

APPLEGATE BAR RANCH c/o BOB & DEANNA COPELAND

Surveyed **JAN. 18**, 19**84**, by **B.S. JAMES**