


T. 1N., R. 4W., W.M.

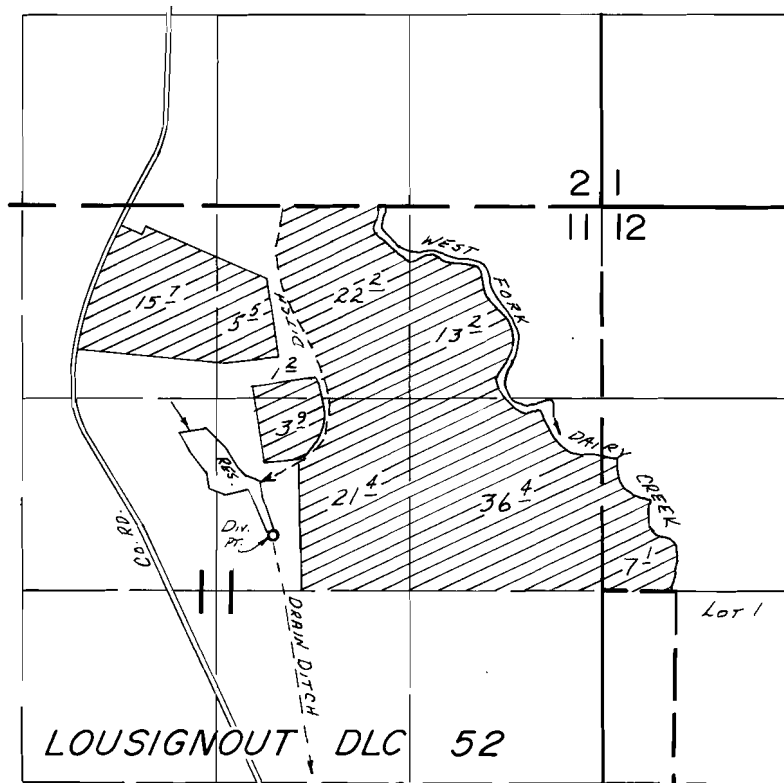

DIV. PTS. LOC.: UNY. DRAINAGE WAY, 2260 S. & 2250 W.,
FROM NE COR. LOUSIGNOUT DLC 52.

SCALE: 1" = 1320'

FINAL PROOF SURVEY UNDER

Application No. 57665... Permit No. 43390.....

IN NAME OF

VERNON E. LYDA.....

Surveyed Aug. 21... 19.84, by B.W. BISHOP.....