


T.6S.,R.5&6W.,W.M.

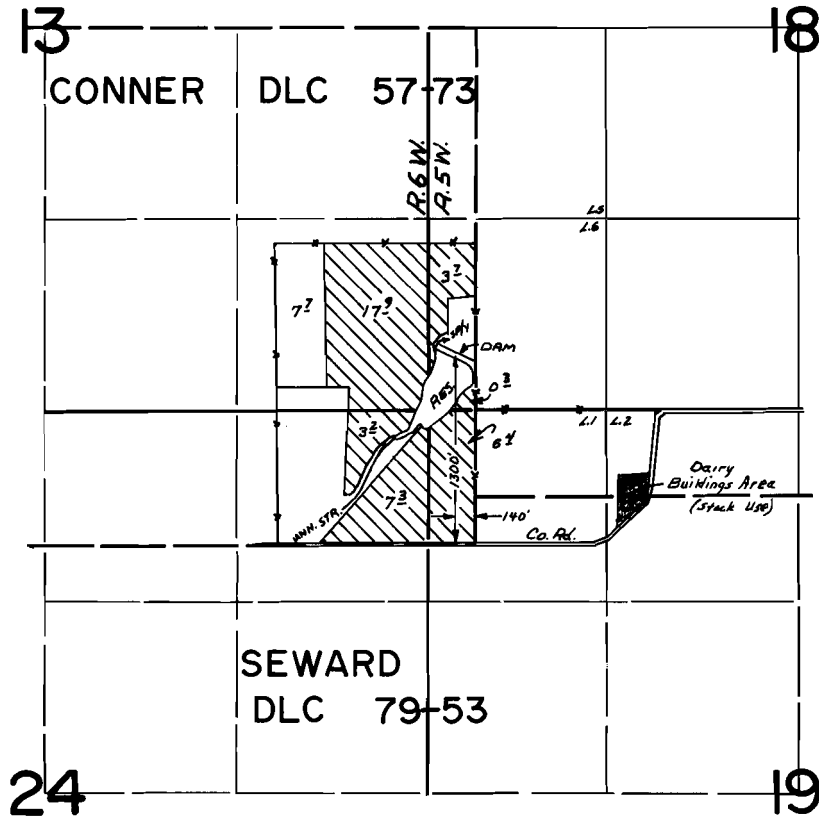

FINAL PROOF SURVEY  
UNDER

R-57734                      R-7696  
Application No. 57735... Permit No. 43448.....  
IN NAME OF

CALVIN & MARIECA HAIGHT.....

Surveyed Nov. 12, 1981, by L. TOLL.....