


T.6S.,R.5&6W.,W.M.

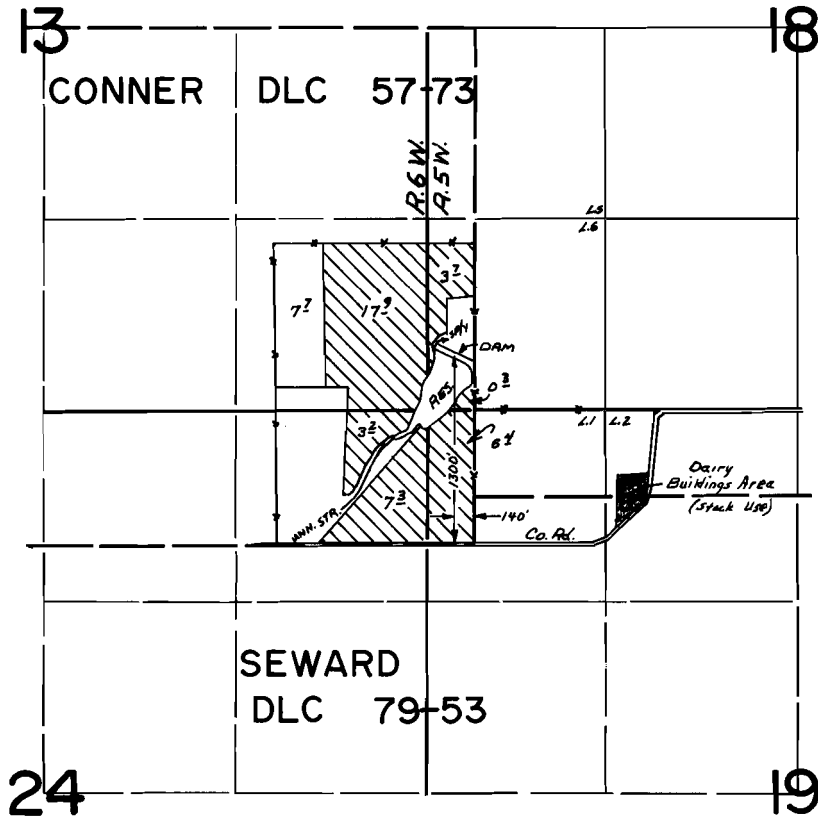

FINAL PROOF SURVEY
UNDER

R-57734 R-7696
Application No. 57735... Permit No. 43448.....
IN NAME OF

CALVIN & MARIECA HAIGHT...

Surveyed Nov. 12, 1981, by L. TOLL.....