


T.26S.,R.6W.,W.M.

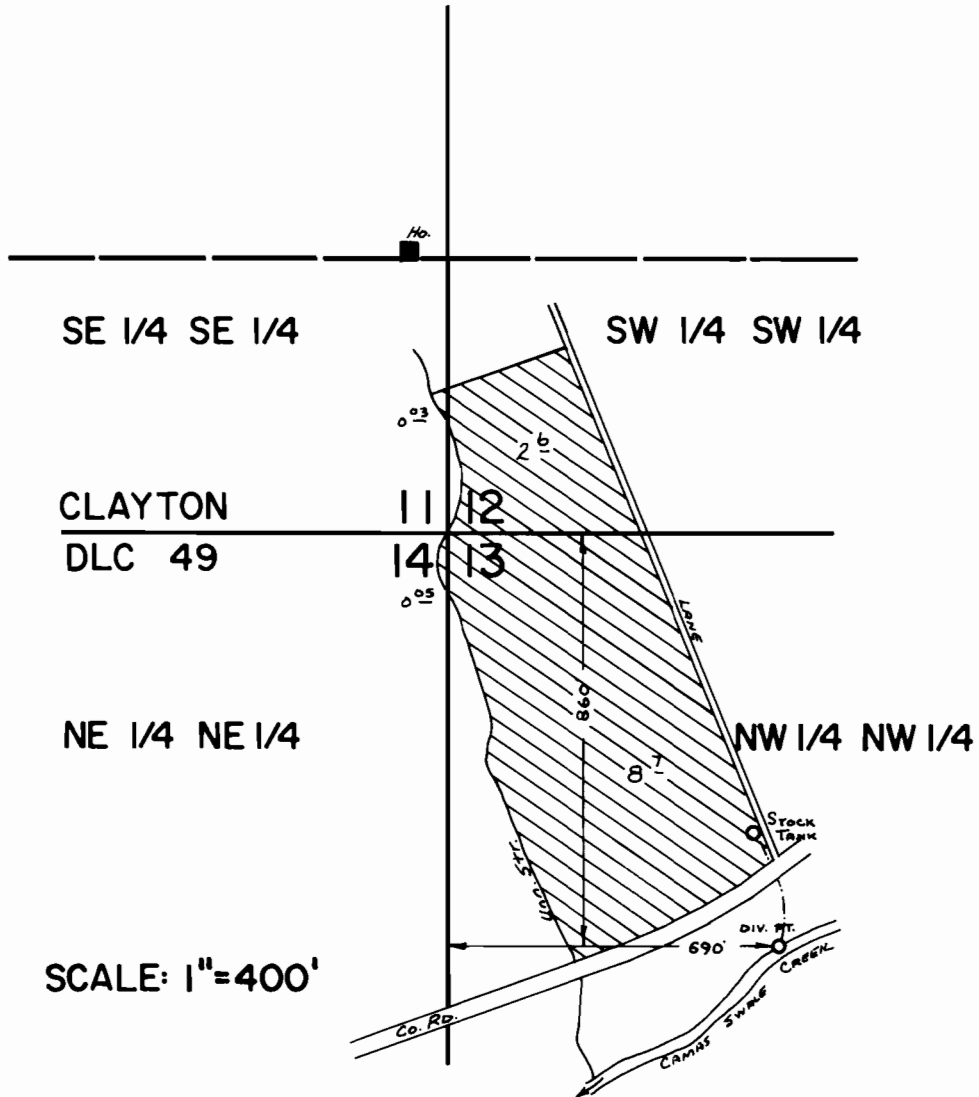

SCALE: 1"=400'

FINAL PROOF SURVEY UNDER

Application No. ...57.760. Permit No. ...43.490.....
IN NAME OF

WILLIAM E. & SUE ALLEN COX.

Surveyed Aug...12... 1982., by L.M. TOLL.....