


# T. 26 S., R. 4 W., W.M.

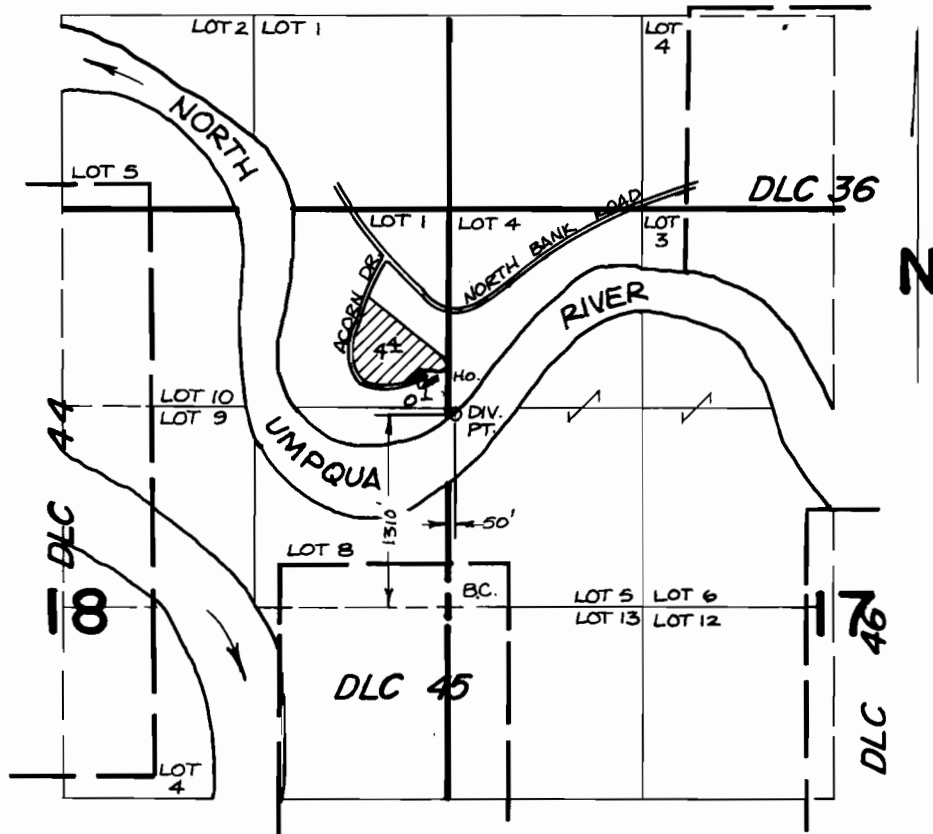

*Note: Stock use within irrigated area.*

SCALE : 4" = 1 MILE

## FINAL PROOF SURVEY UNDER

Application No. 57799 Permit No. 43743

IN NAME OF

**H.E. KELLEY**

Surveyed SEPT. 9, 1986, by J.M. SCHMORDE