


T. 36 S., R. 3 W., W. M.

Sec. 21

NW 1/4 NW 1/4

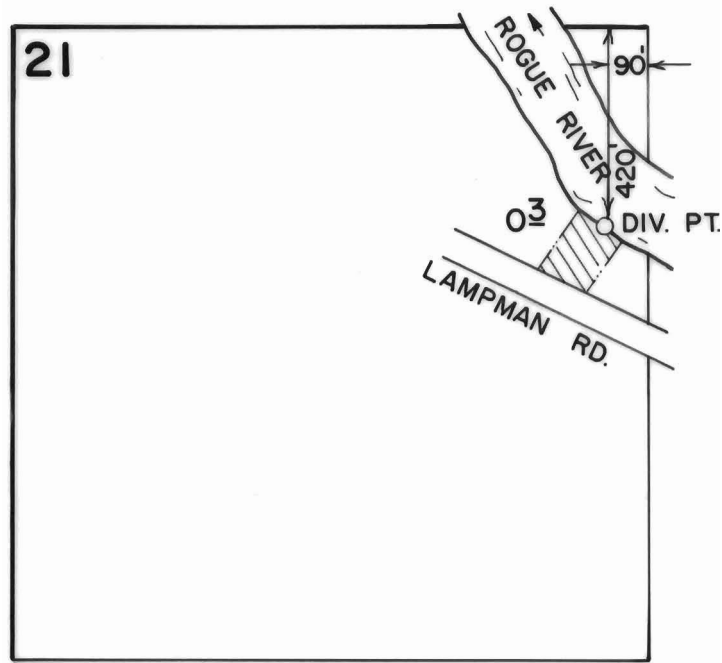

Scale 1" = 400'

FINAL PROOF SURVEY

UNDER

Application No. 58302.. Permit No. 43941.....
IN NAME OF

Lloyd W. Kangas

Surveyed July...2... 1986, by B.S. JAMES.....