


RECEIVED

SEP 19 1979

WATER RESOURCES DEPT
SALEM, OREGON

T.4N. R.1W. W.M.

Application No. 59308
Permit No. 44604

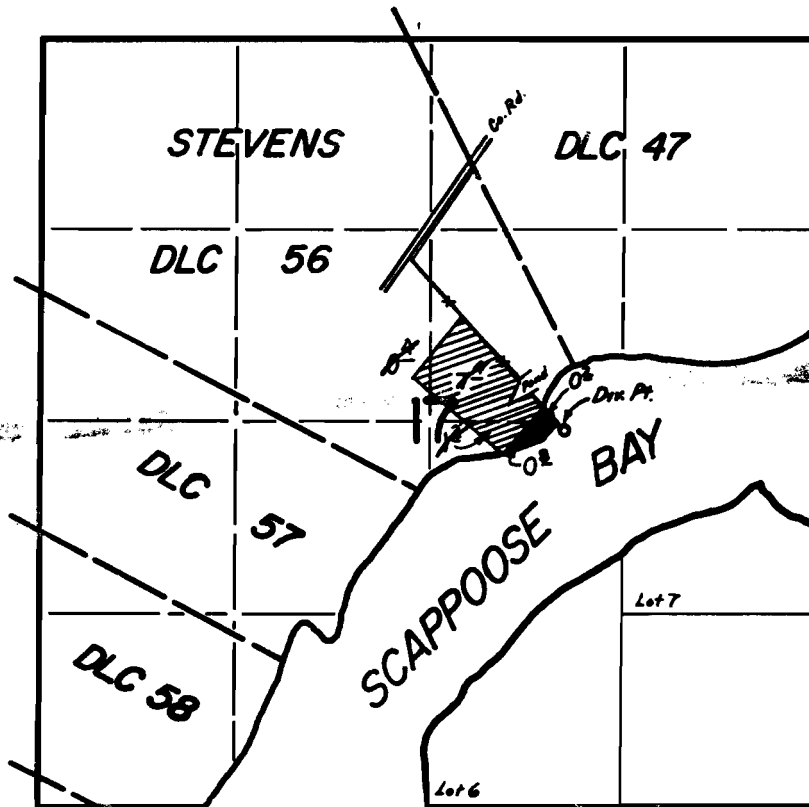

Div Pt. Loc.: 60 ft. S * 920 ft. E. from Center Sec. 17.

~~FINAL PROOF SURVEY~~
UNDER

Application No. 59308 Permit No. 44604
~~55293~~ ~~41479~~

IN NAME OF

VON N. & IDA L. SMITH

Surveyed Sept 20 1978, by S.P. APPLGATE