




T. 25 & 26 S., R. 14 W., W.M.

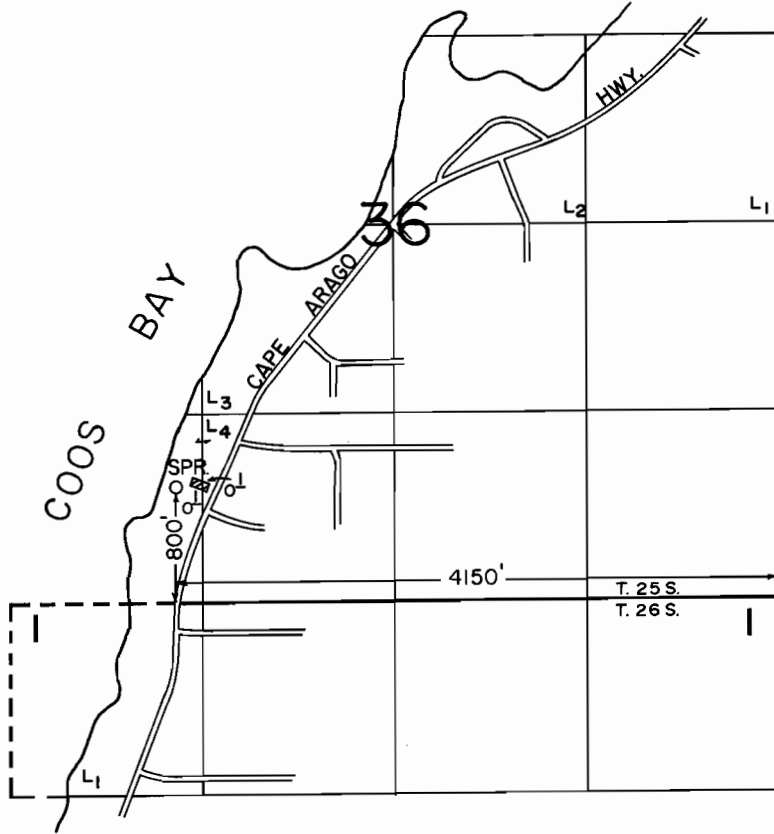

SCALE: 1" = 1320'

**FINAL PROOF SURVEY**  
UNDER

Application No. 59322.. Permit No. 4465!.....  
IN NAME OF

BRUCE W. & HELEN W. BARNARD

Surveyed SEPT. 17. 1988., by L.H. NUNN.....