


T6N, R7W, WM

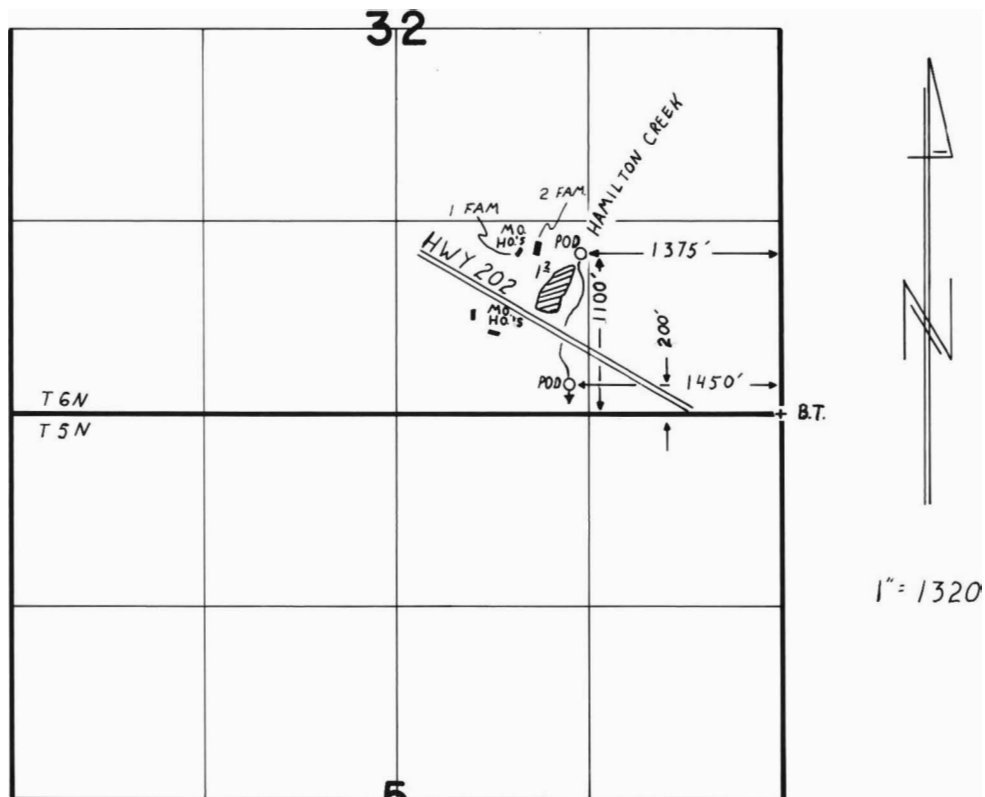

FINAL PROOF SURVEY UNDER

Application No. 60225 45083
 60565 Permit No. 45012.....
 IN NAME OF

CHRISTIAN RETREAT CENTER

Surveyed AUG. 16. 1988, by R.W. KLASSEN.