


T. 36S. R. 14 W. W.M.

RECEIVED

MAY 11 1991

WATER RESOURCES DEPT
SALEM, OREGON

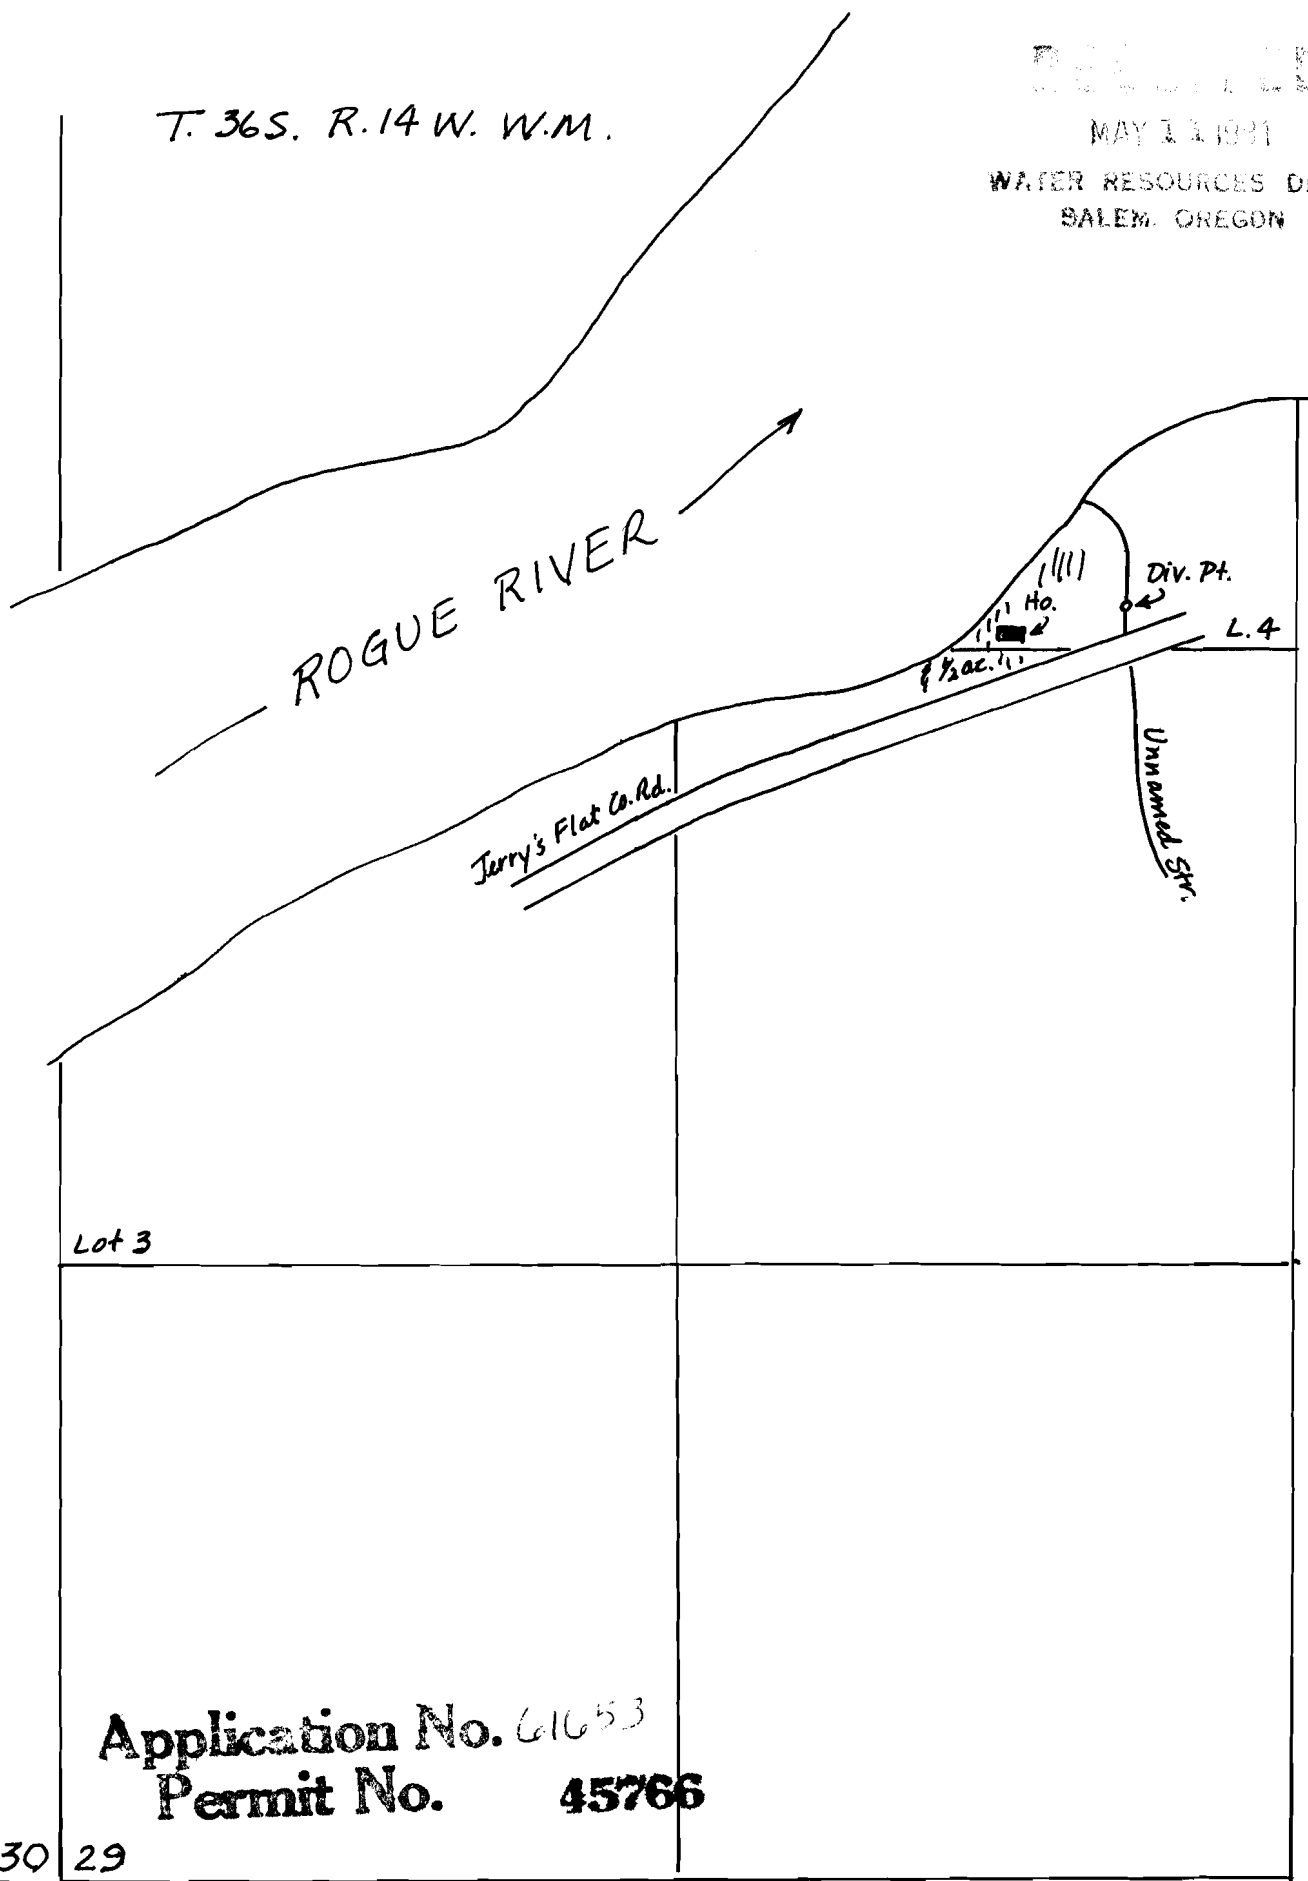

Lot 3

Jerry's Flat Co. Rd.

Unnamed Str.

Div. Pt.

Ho.

L. 4

Application No. 61653
Permit No. 45766

30 29
31 32

Scale: 1" = 400'

Div. Pt.: 75' N. and 360' W from
the SE Cor of Govt Lot 4.