


T. 3S., R. 40E., W.M.

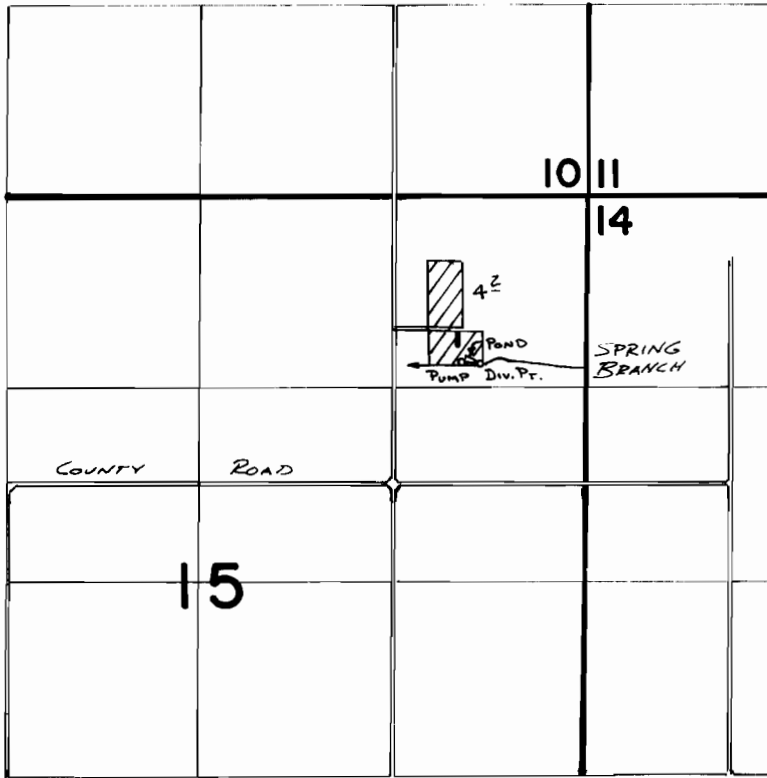

Div. Pt. Loc: 1140'S. & 730'W. FROM NE COR. SEC. 15

FINAL PROOF SURVEY
UNDER

Application No. **R-62425** Permit No. **R-8381**
62426 **46571**
IN NAME OF

RAY M. & LUELLA KELLOGG

Surveyed *6-8* 19*88*, by *V.L. Church*