




T. 27 S., R. 11 & 12 W., W.M.

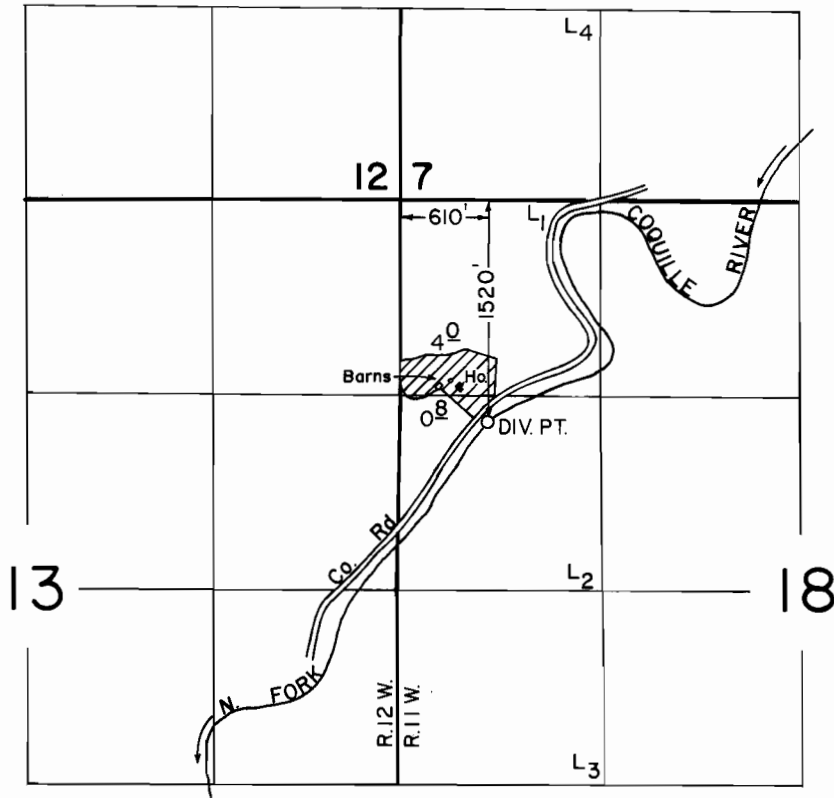

SCALE: 1" = 1320'

**FINAL PROOF SURVEY**  
UNDER

Application No. 65042.. Permit No. 47788.....  
IN NAME OF

.....EDWARD C. MOODY.....

Surveyed SEPT. 19. 1988., by Z. SALEH.....