




T. 26S., R. 13W., W.M.

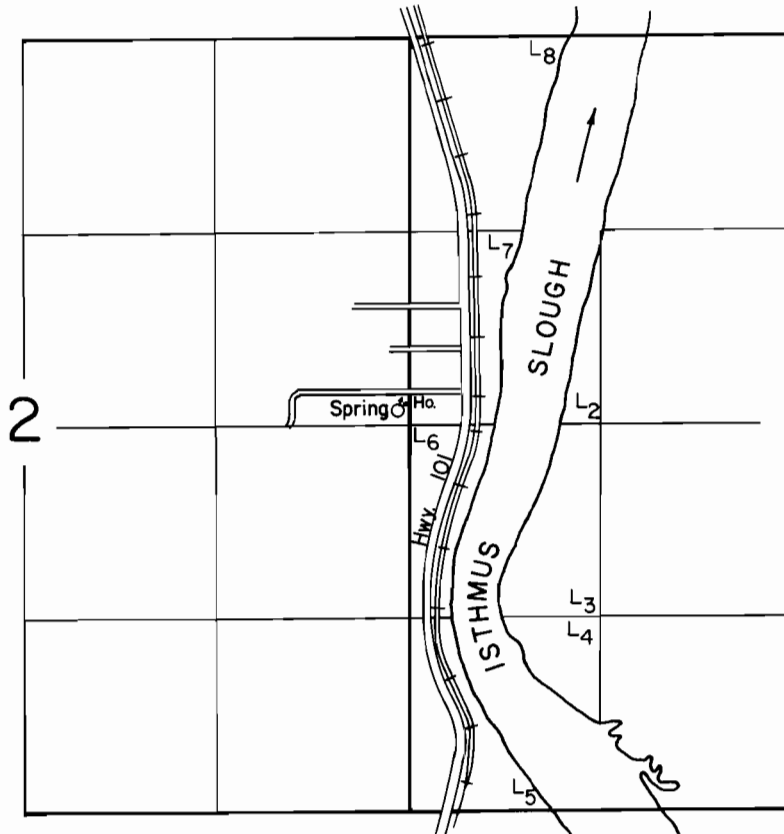

SPRING LOC: 110' N. & 80' W. FROM E. 1/4 CORNER SECTION 2

SCALE: 1" = 1320'

FINAL PROOF SURVEY
UNDER

Application No. 65531... Permit No. 47967.....
IN NAME OF

.....CLYDE E. IRION.....

Surveyed SEPT. 20 1988., by L. H. NUNN.....