


T.14S. R.6W. W.M.

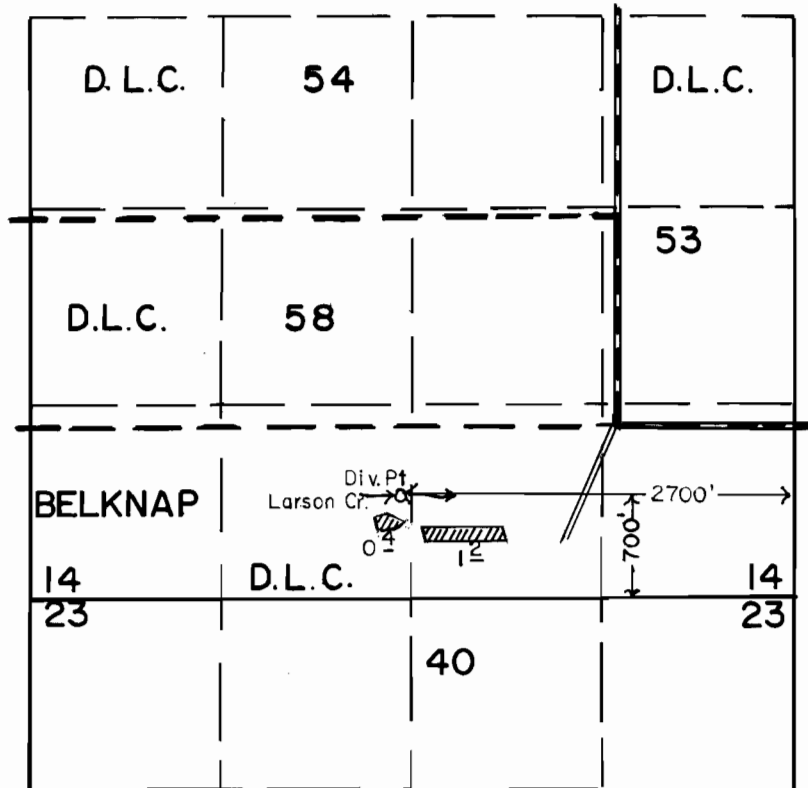

SCALE: 1"= 1320'

FINAL PROOF SURVEY

UNDER

Application No. ~~67096~~.. Permit No. ~~4817.7~~.....
IN NAME OF

...WILLIAM E. & DIANA L. GAMACHE...

Surveyed ..OCT. 7..... 19.87., by T.M. WARREN.....