


T. 1 N., R. 4 W., W.M.

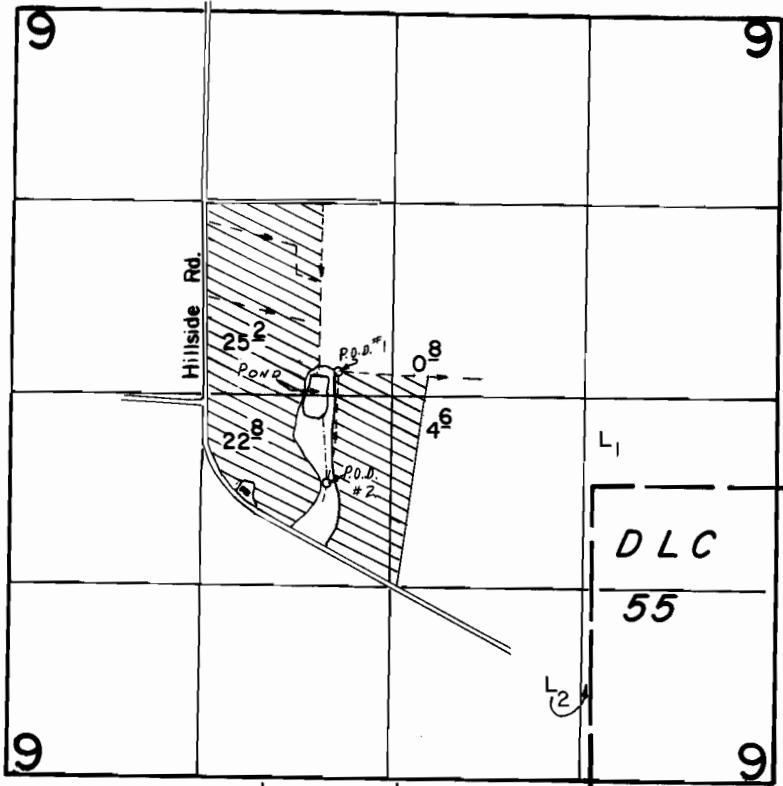

P.O.D. 1 Loc. : 1150' S. & 920' E.
 P.O.D. 2 Loc. : 1910' S. & 860' E.
 Pond P.O.D. Loc. : 1200' S. & 730' E. : all from NW Cor. SE 1/4 NW 1/4, Sec. 9.

Scale : 1" = 1320'

FINAL PROOF SURVEY UNDER

R-68473 R-10529
 Application No. 68534 Permit No. 49461
 IN NAME OF

..... DAVID W. HORNER

Surveyed AUG. 29. 1988., by T. Warren.....