


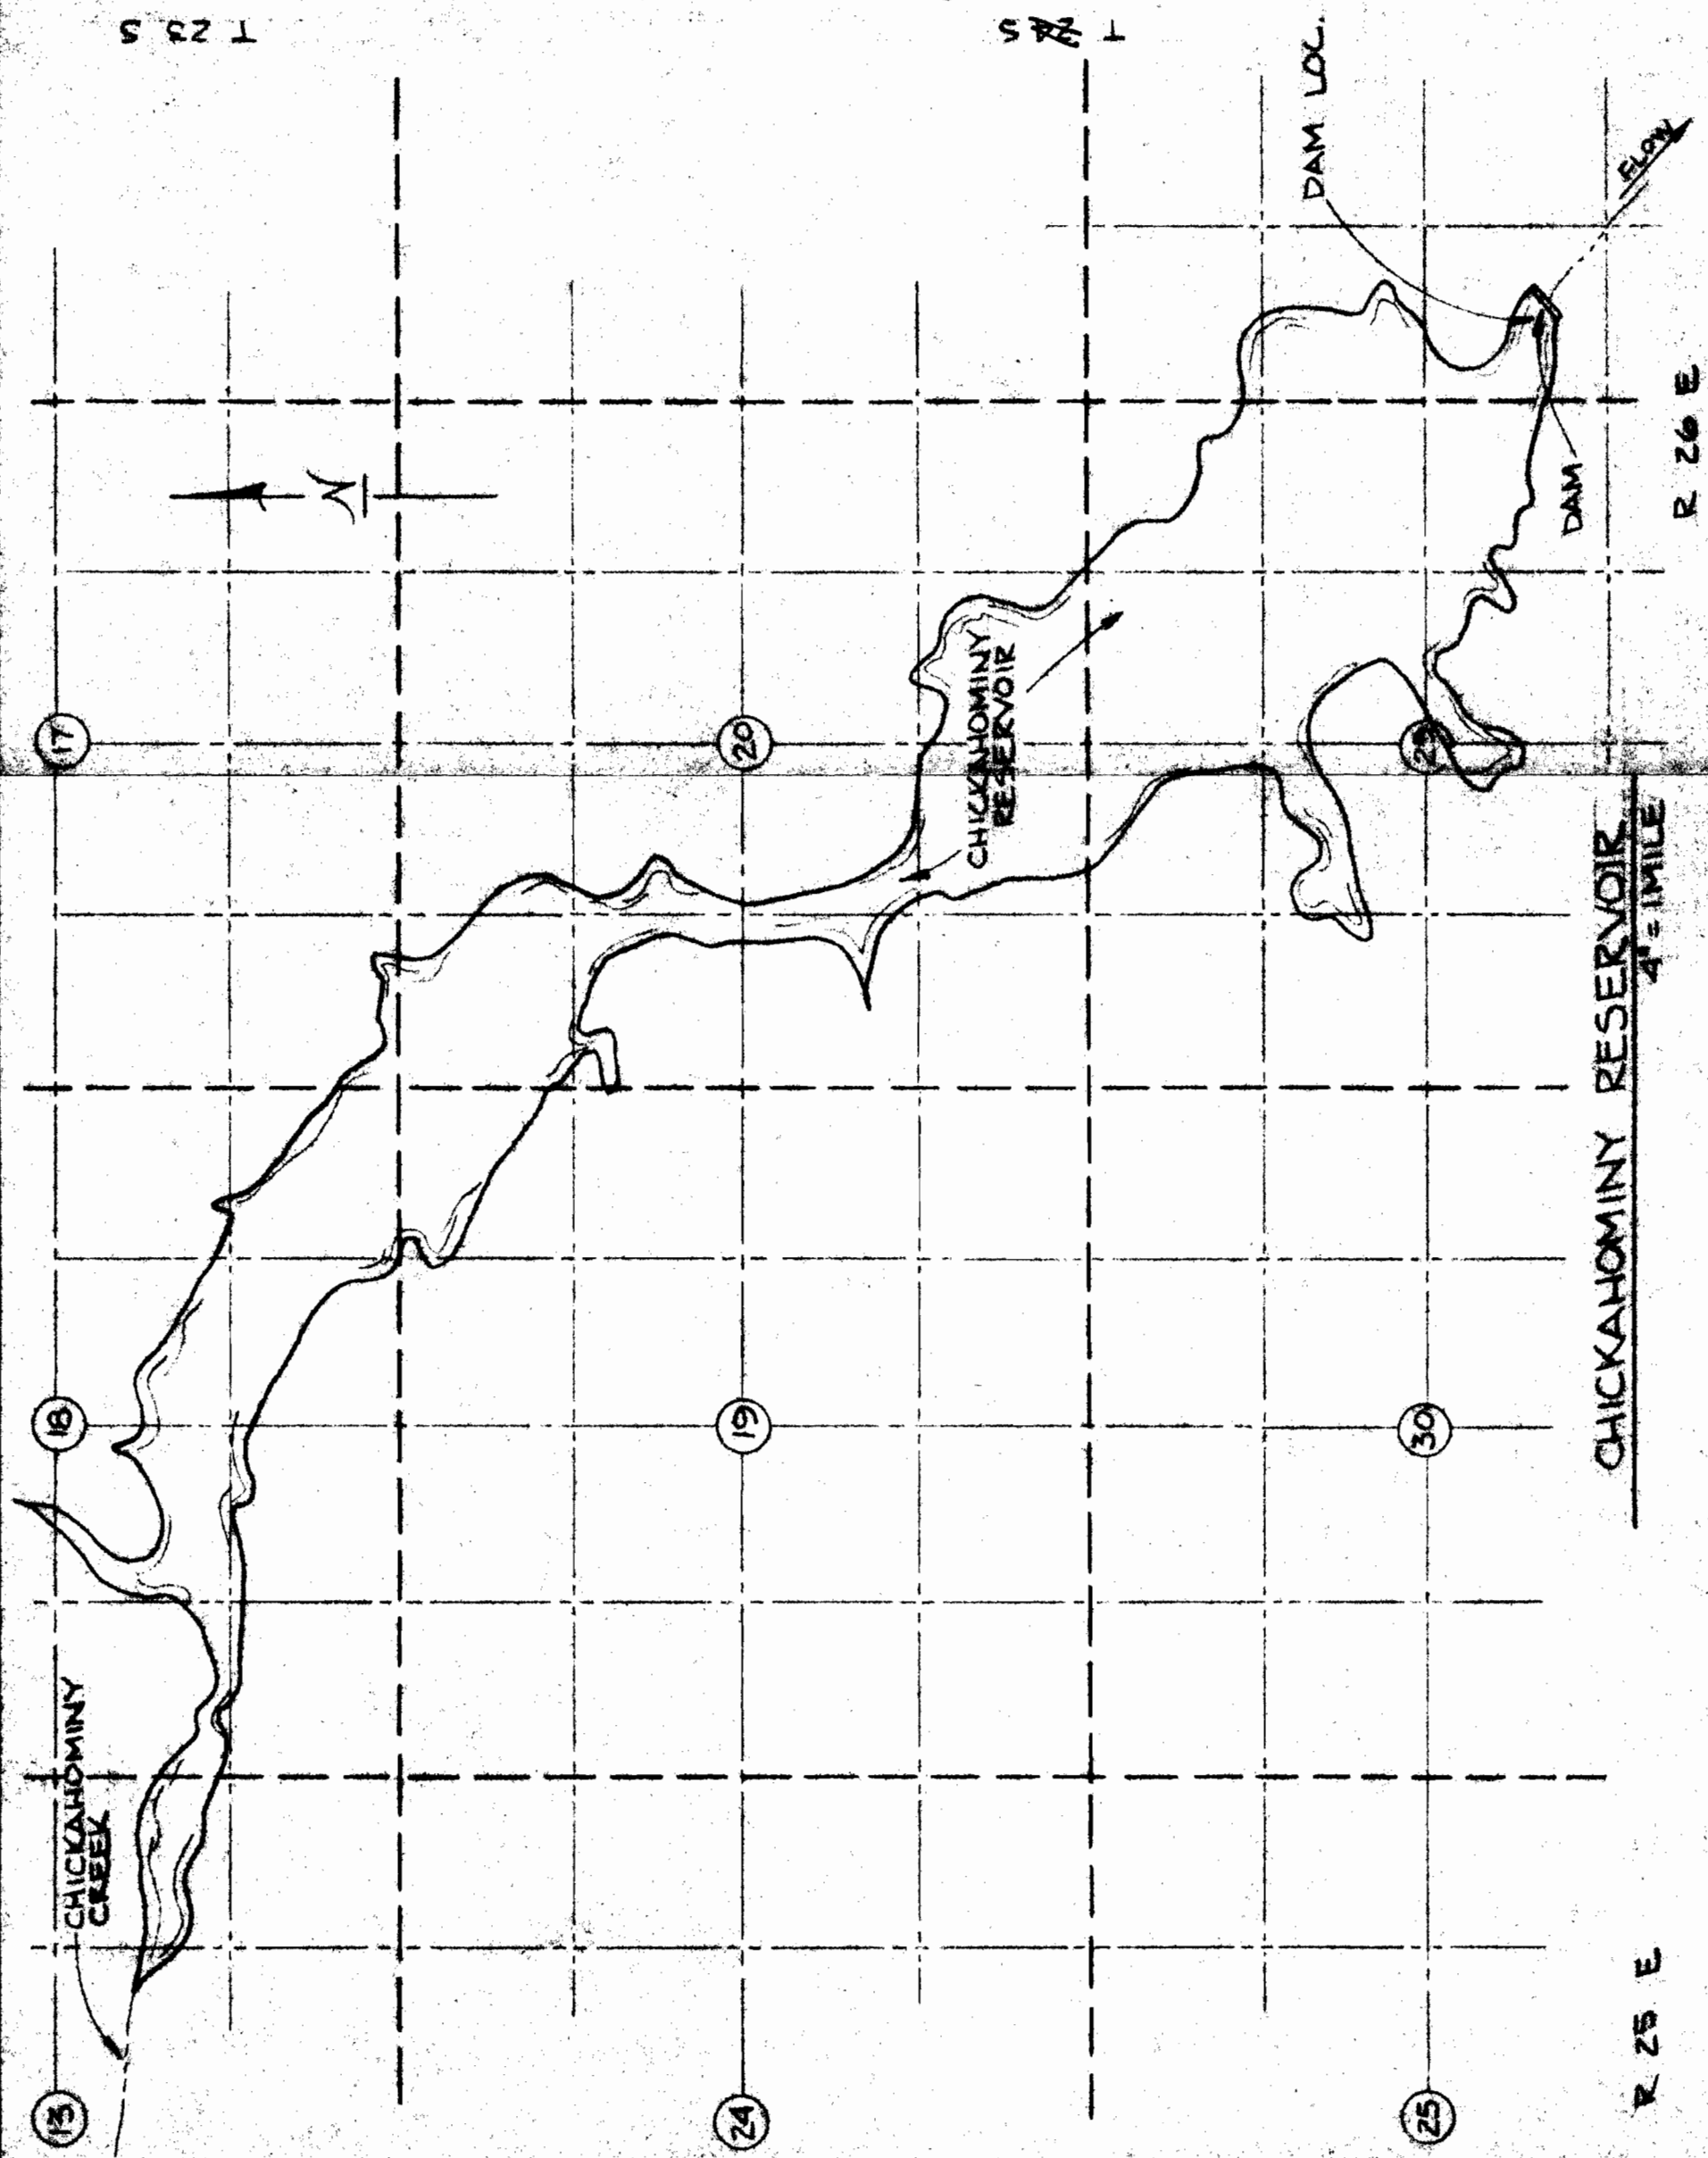

Application No. *R-168650*
Permit No. R10618

RECEIVED

JAN 16 1986

WATER RESOURCES DEPT
SALEM, OREGON

DAM LOC. 3471.6' S. AND
726' E. FROM
N.W. CORNER SEC. 28

DEPT OF FISH & WILDLIFE STATE OF OREGON		CHICKAHOMINY RESERVOIR	
JAN, 1986	DW	SAT. 1 OF 1	