

Application No. 68727

Permit No. 49651

RECEIVED

JUN 1 1986

WATER RESOURCES DEPT

SALEM, OREGON

RECEIVED

JUN 12 1986

WATER RESOURCES DEPT

SALEM, OREGON

This plat is for your aid in locating your land with reference to streets and other parcels. While this plat is believed to be correct, the company assumes no liability for any loss by reason of reliance thereon.

SAFECO TITLE INSURANCE COMPANY OF OREGON


SEE MAP 19 12 23 2

RECEIVED

MAY 14 1986

WATER RESOURCES

SALEM, OREGON

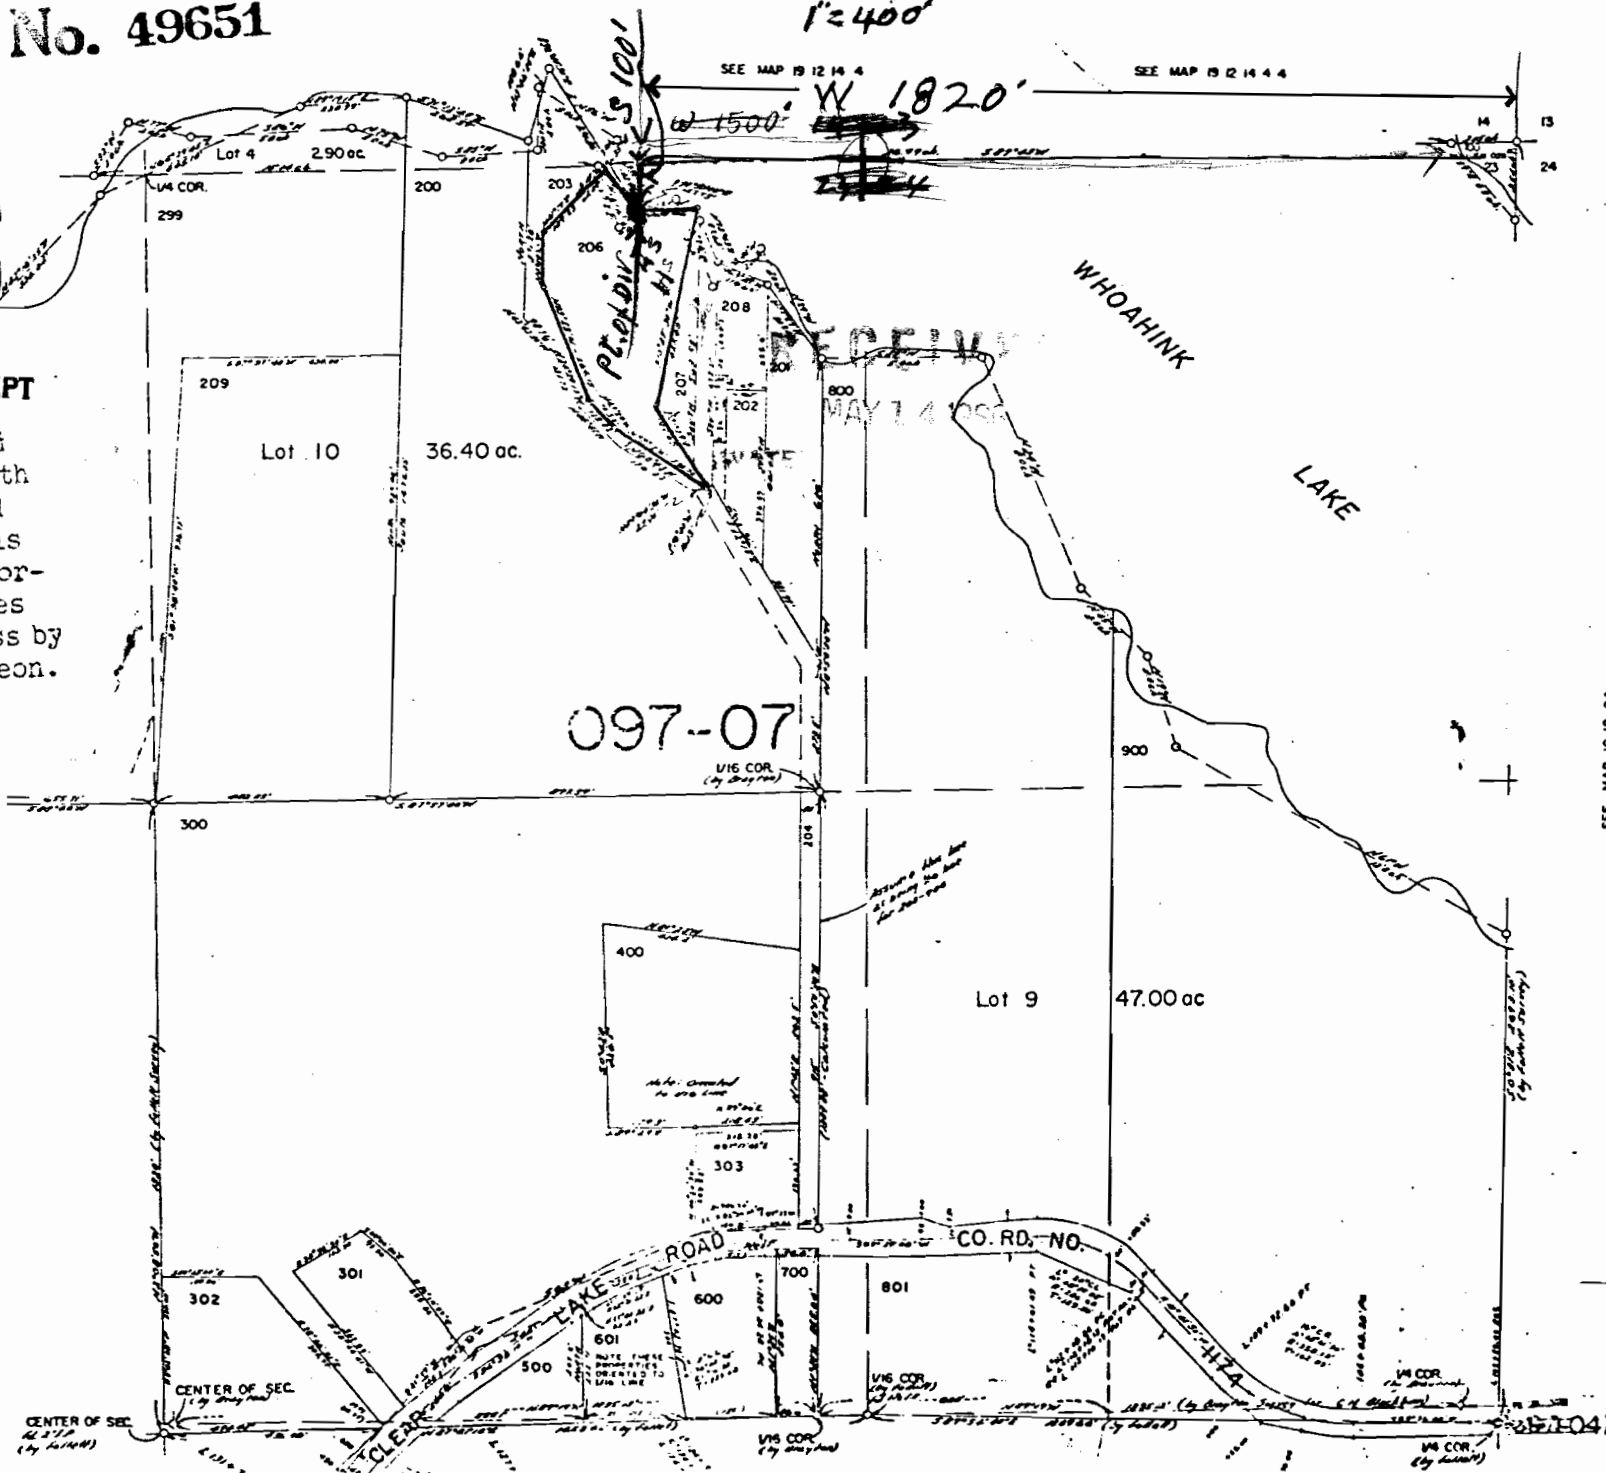

SEE MAP 19 12 24

SEE MAP 19 12 24