


T. 37 S., R. 7 W., W. M.

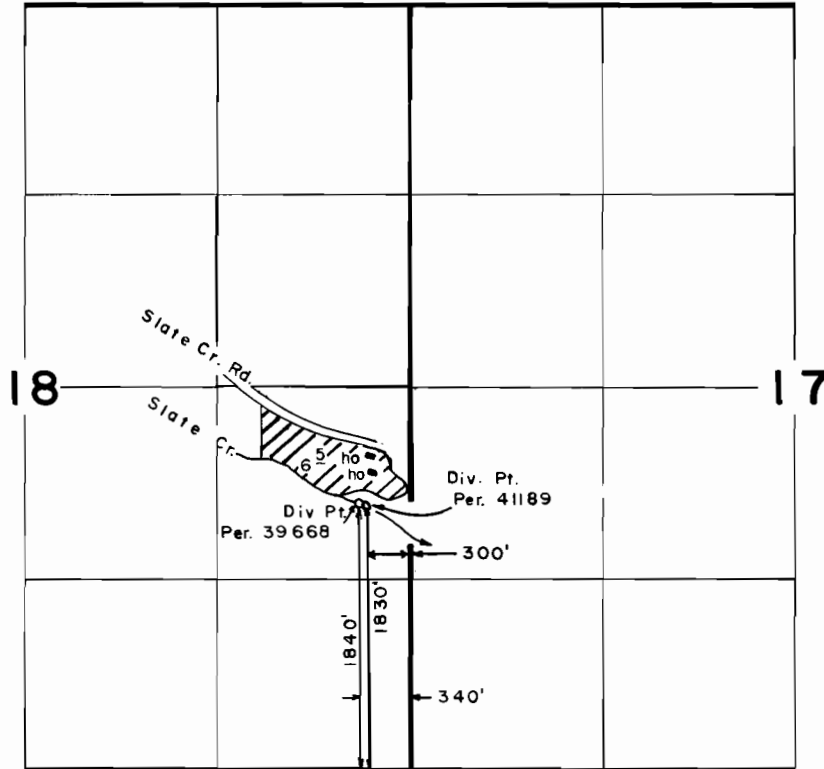

Scale: 1" = 1320"

FINAL PROOF SURVEY
UNDER

52614 39668
Application No. 54912. Permit No. 41189.....
IN NAME OF

NORMAN E. & DAISY T. BILLER

Surveyed JUL. 23. 1986, by B. S. JAMES...