


MAY 5 1921

SAI PM. OREGON IN.

MAP
ROGERS-BETTS IRRIGATION DITCH.
 Scale 2" = 1 Mile.

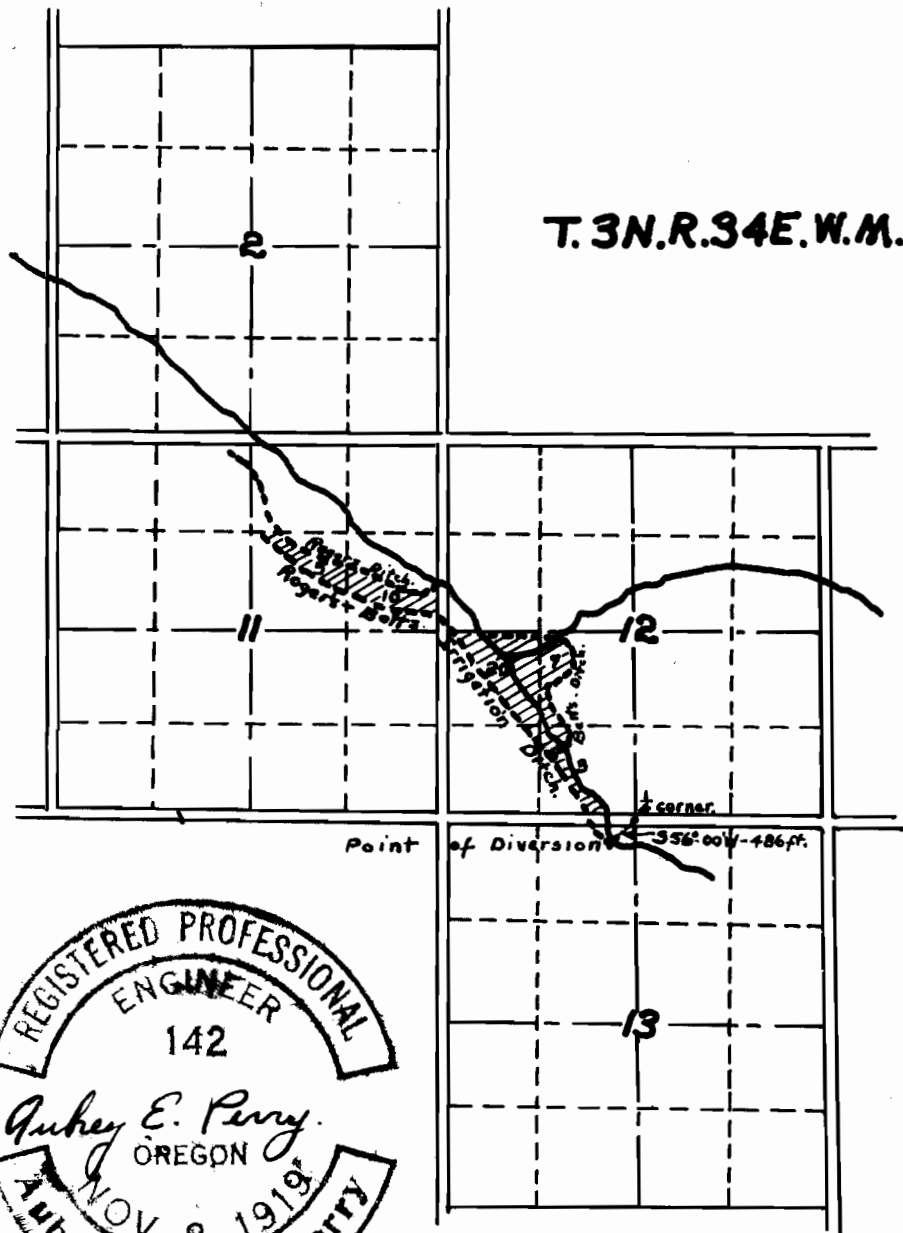

REGISTERED PROFESSIONAL
 ENGINEER
 142
Aubrey E. Perry
 OREGON
 NOV. 8, 1919
 Aubrey Eugene Perry