


R-9016

RECEIVED

AUG 25 1983
WATER RESOURCES DEPT.
SALEM, OREGON

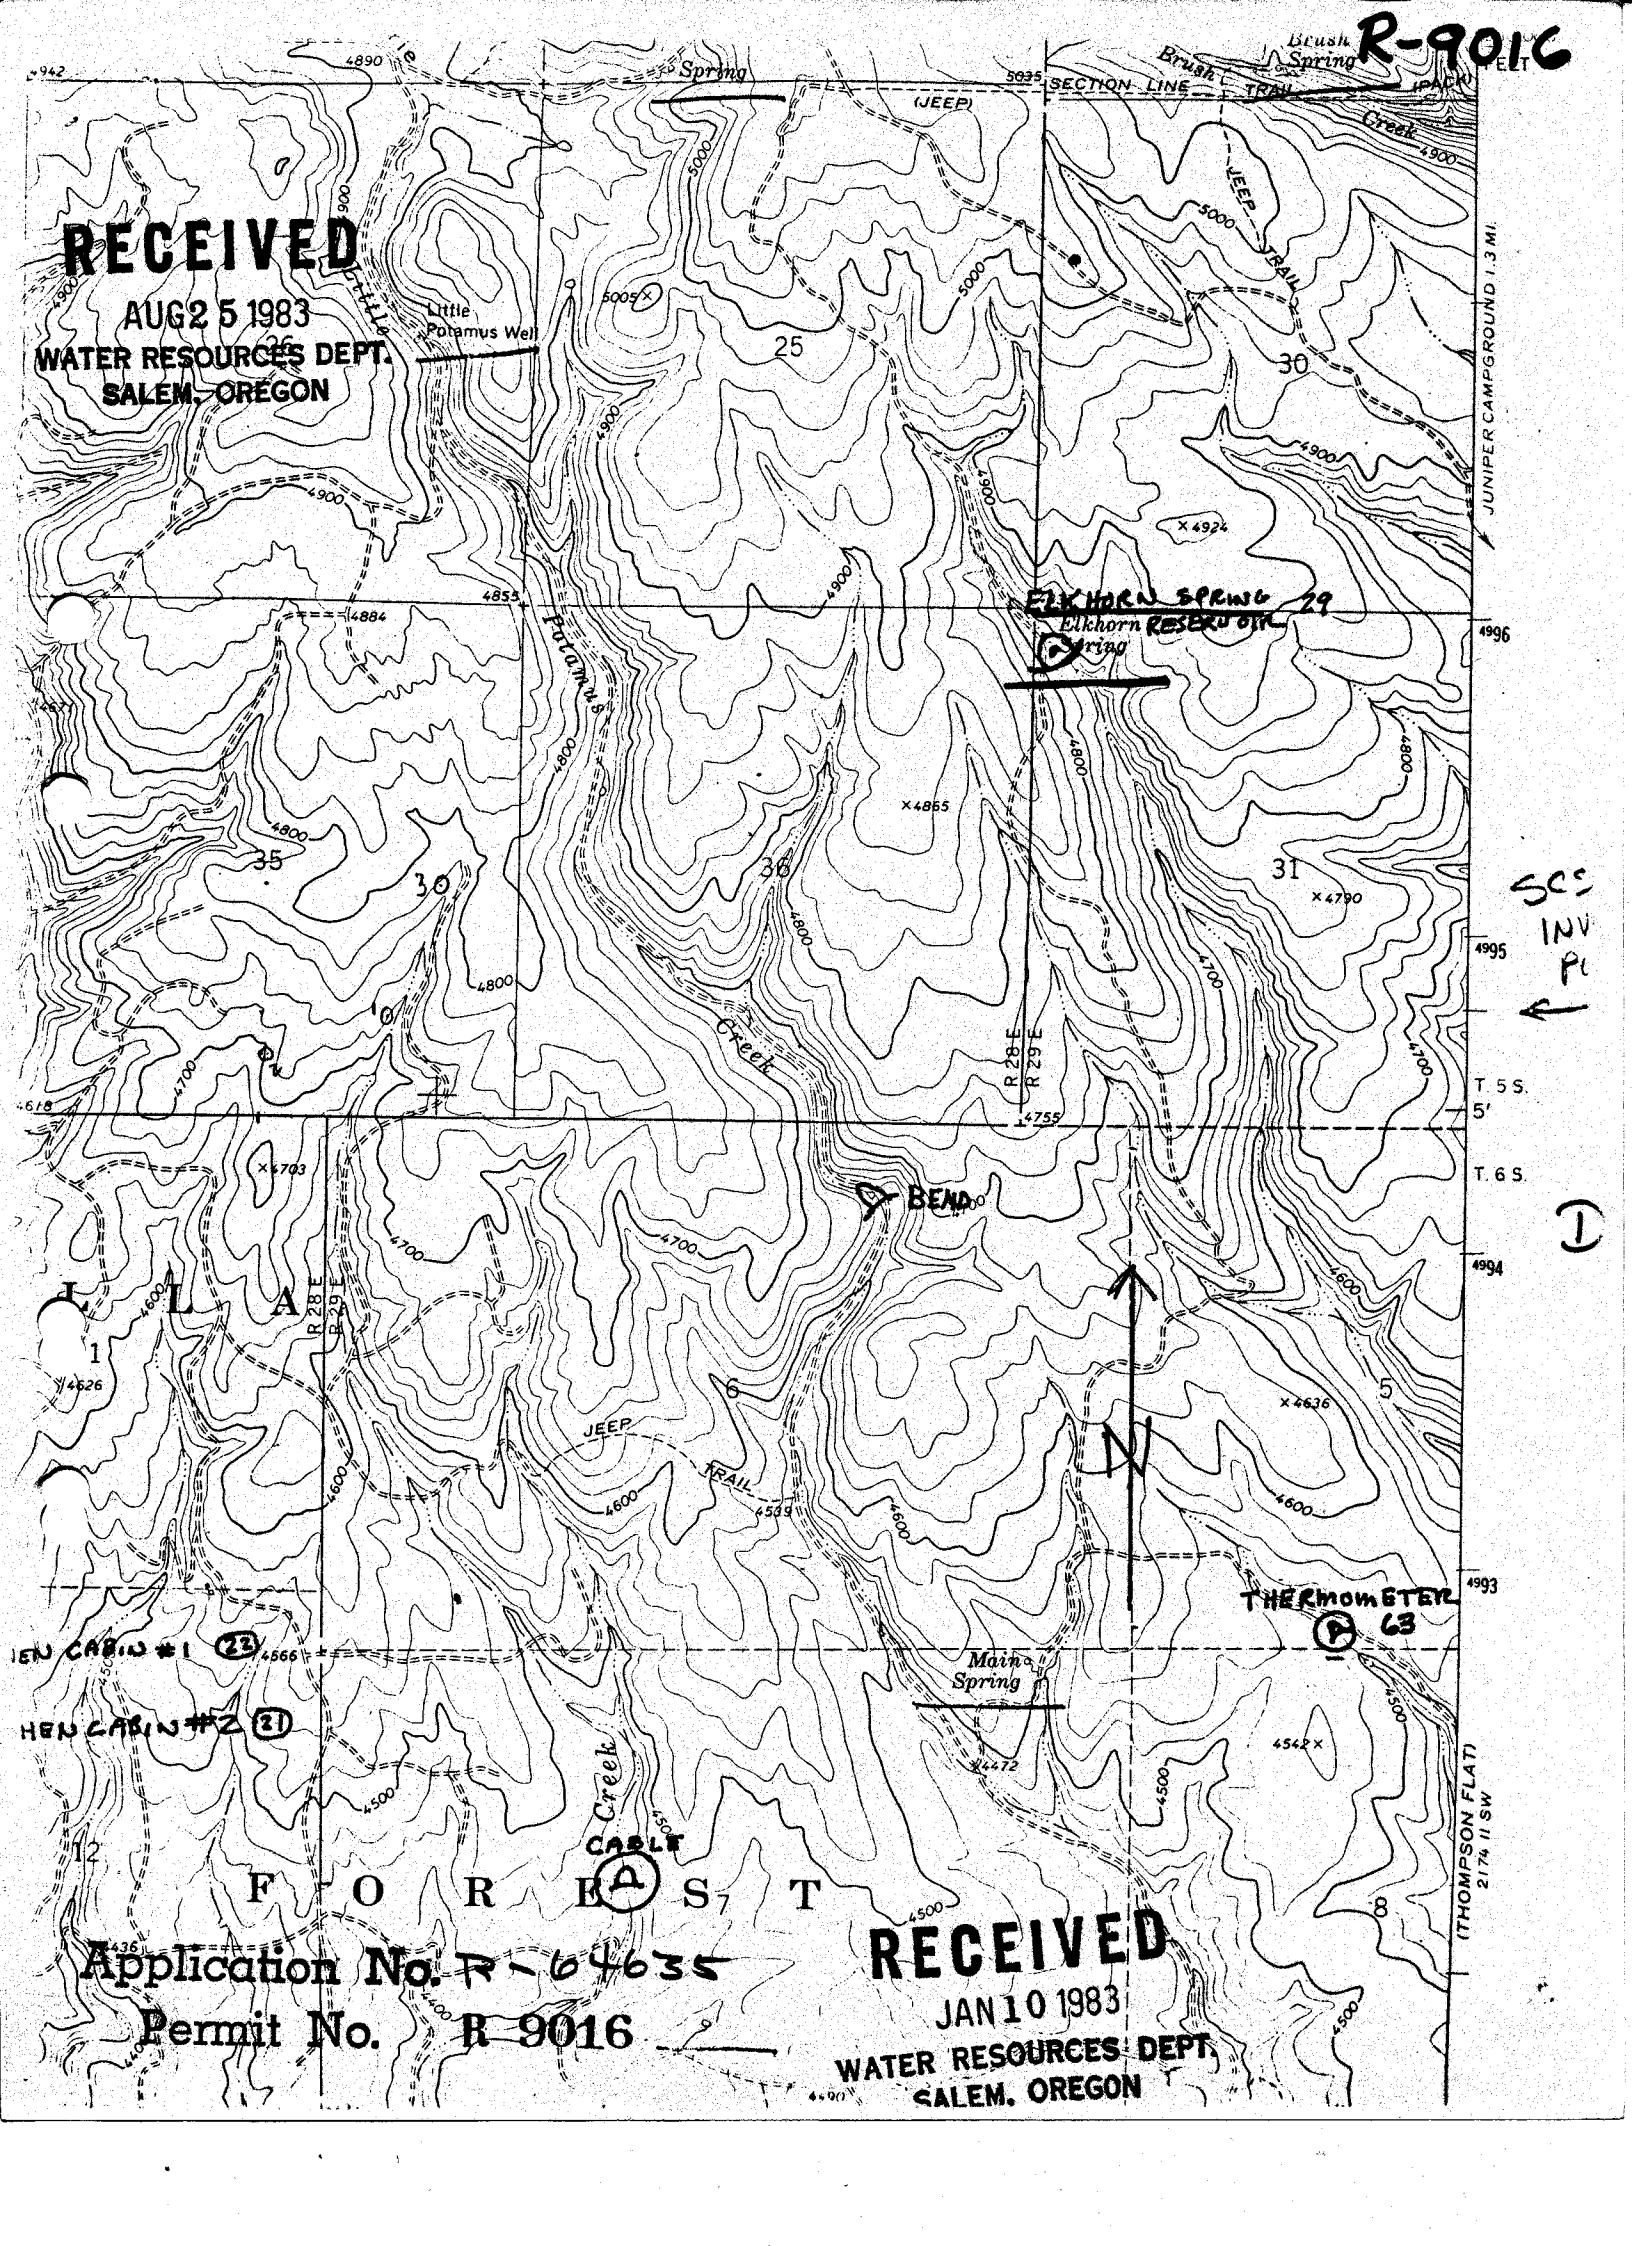

SCS
INV
PL
↑

D

Application No. R-64635
Permit No. R-9016

RECEIVED

JAN 10 1983
WATER RESOURCES DEPT.
SALEM, OREGON