


R-9027
RECEIVED

AUG 25 1983

WATER RESOURCES DEPT
 SALEM, OREGON

UNITED STATES
 DEPARTMENT OF THE INTERIOR
 GEOLOGICAL SURVEY

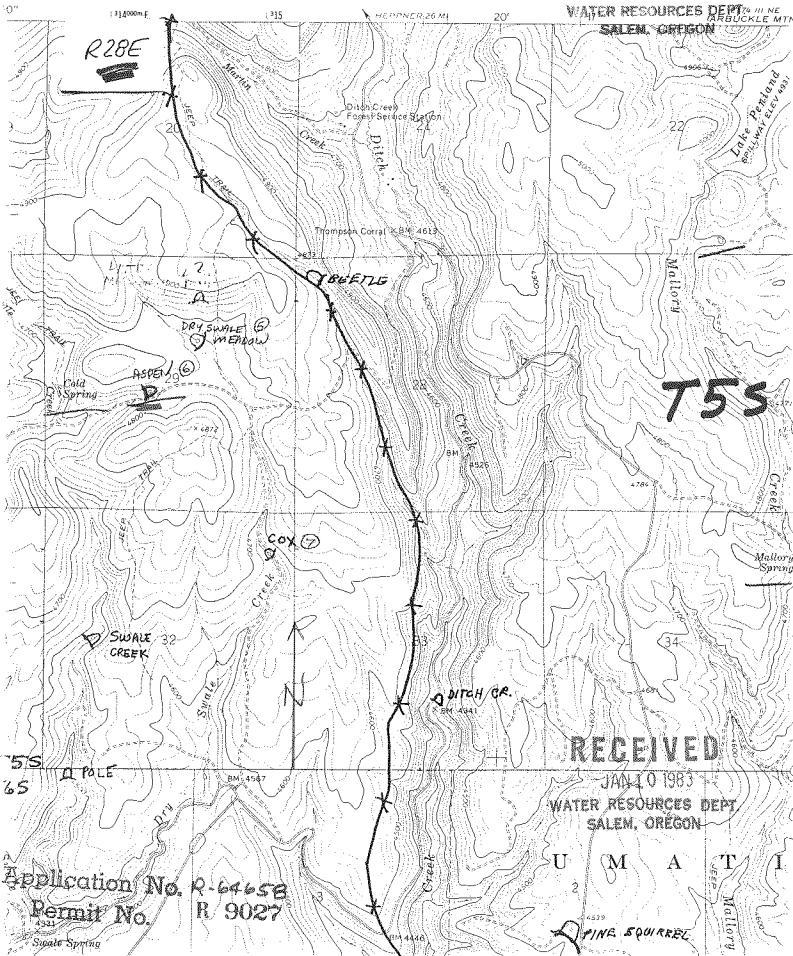

Application No. R-64658
 Permit No. R 9027

RECEIVED
 JAN 10 1983
 WATER RESOURCES DEPT
 SALEM, OREGON

U M A T I
 2
 FINE SQUIRREL