


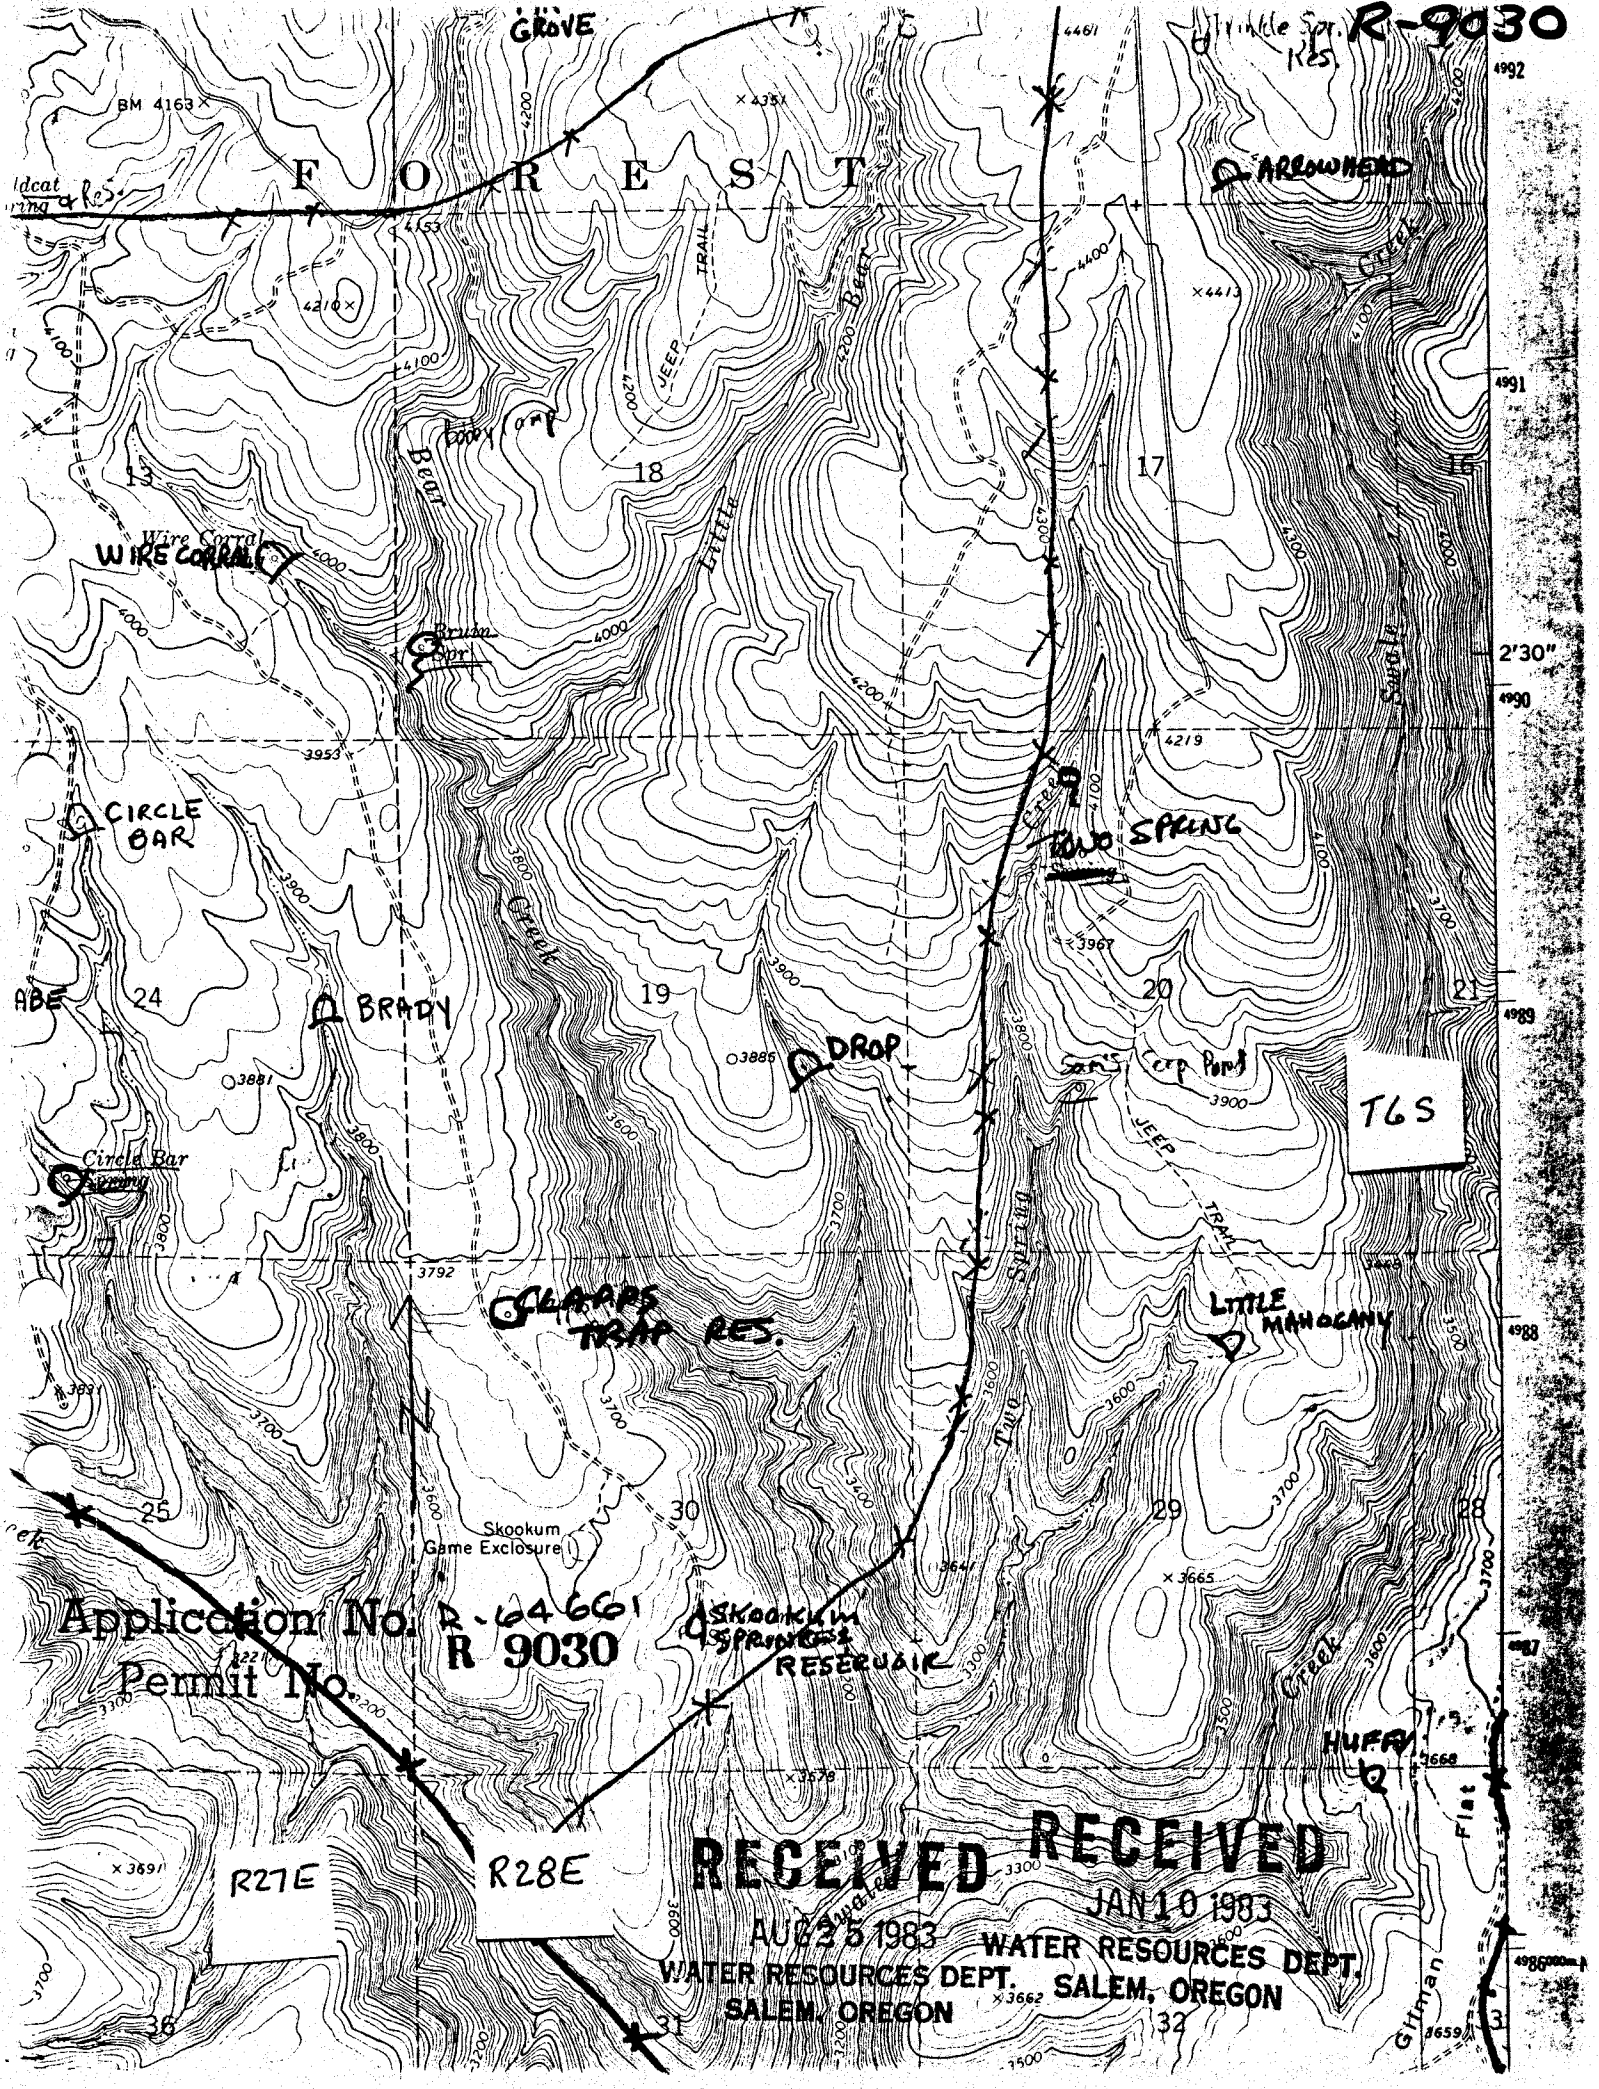

R-9030

T6S

Application No. R-164661
Permit No. R 9030

RECEIVED RECEIVED

AUG 25 1983

JAN 10 1983

WATER RESOURCES DEPT. SALEM, OREGON