


R-9038
61206

TOWNSHIP 65, RANGE 26E, SECTION 14, W.M.

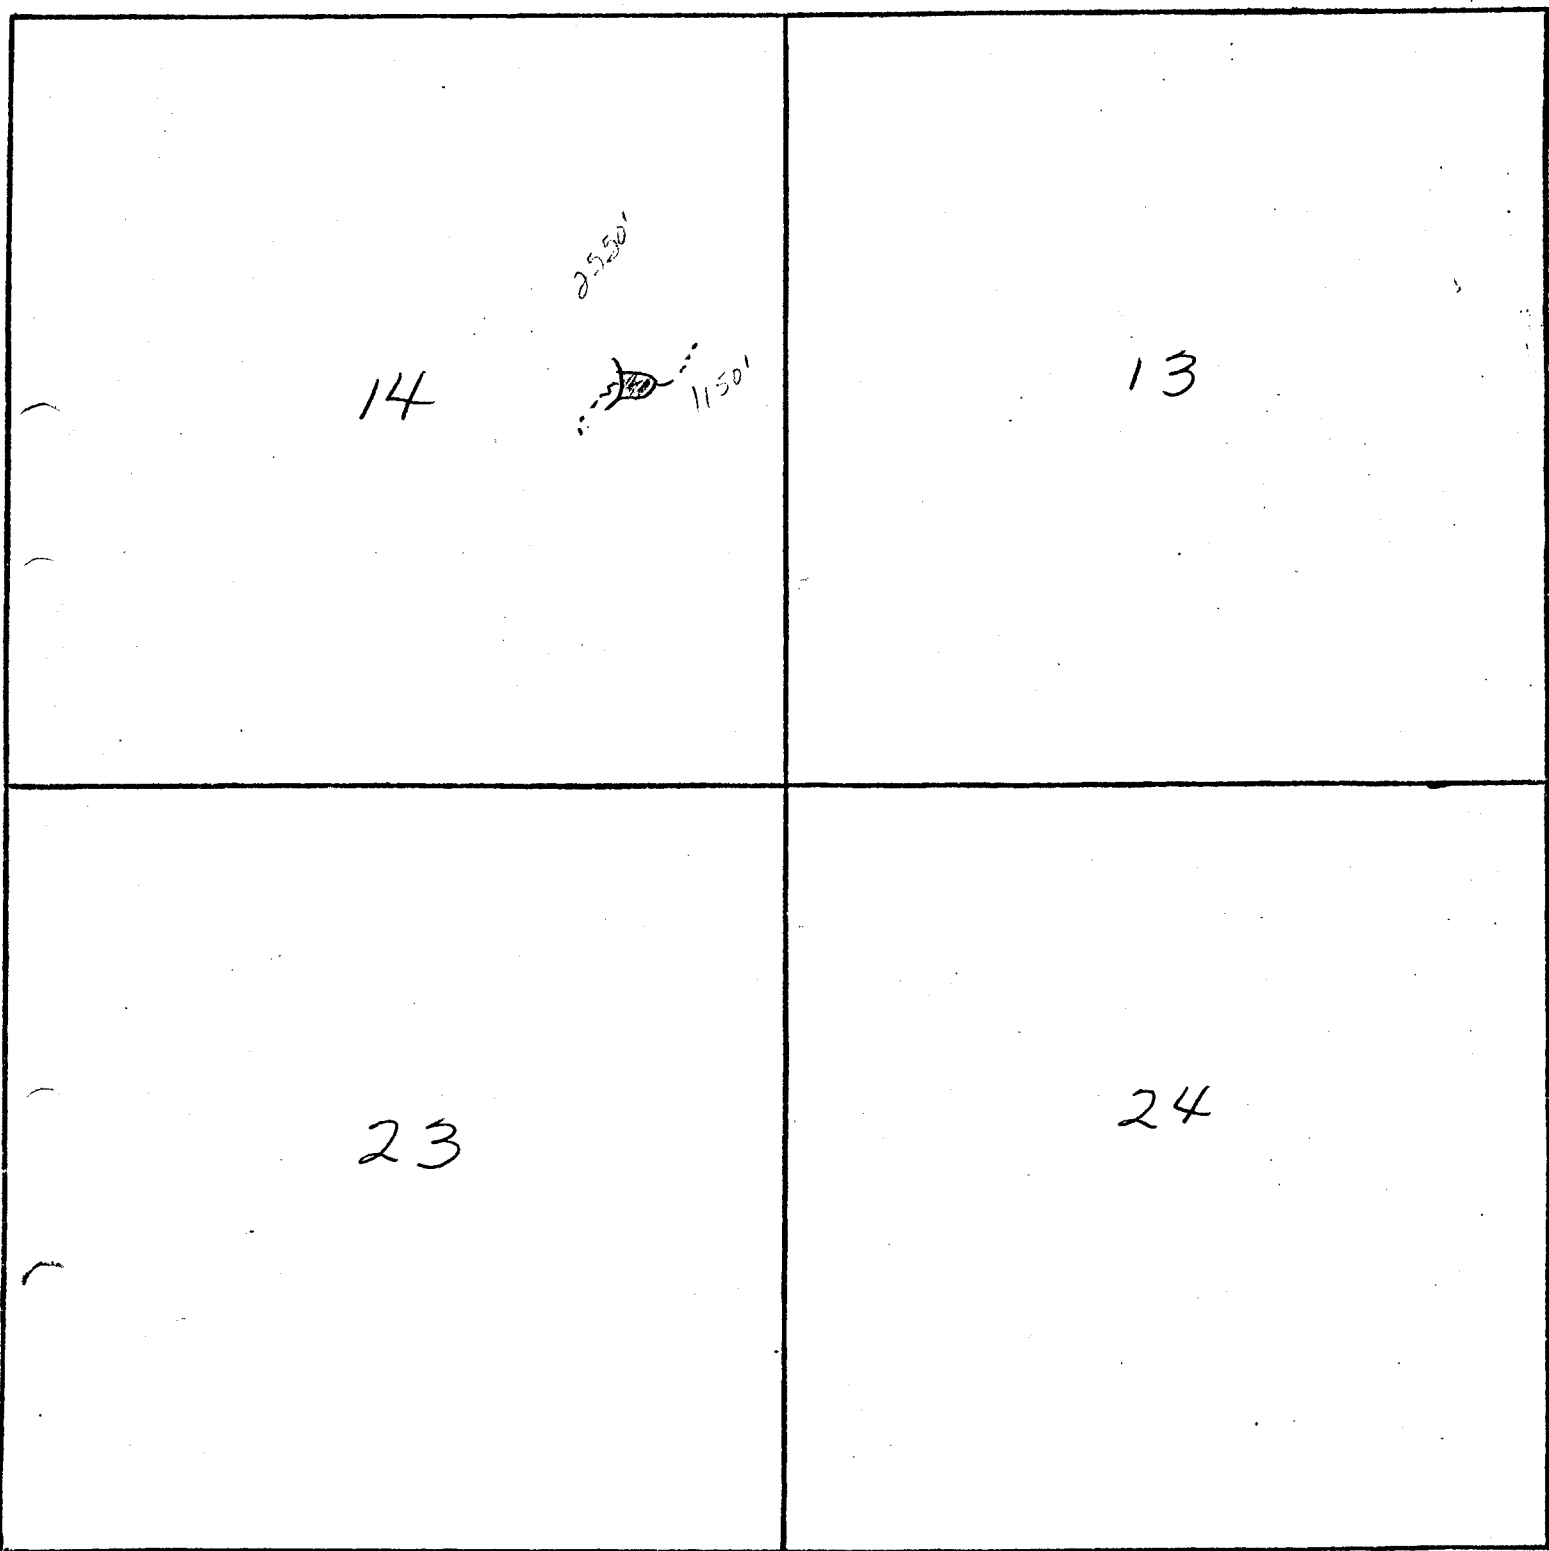

NAME SPERRY RES.

Application No. 2-64681

Permit No. R 9038

RECEIVED RECEIVED
COUNTY MORRISON

AUG 25 1983

JAN 10 1983

13

WATER RESOURCES DEPT.
SALEM, OREGON

WATER RESOURCES DEPT.
SALEM, OREGON