


R-9042

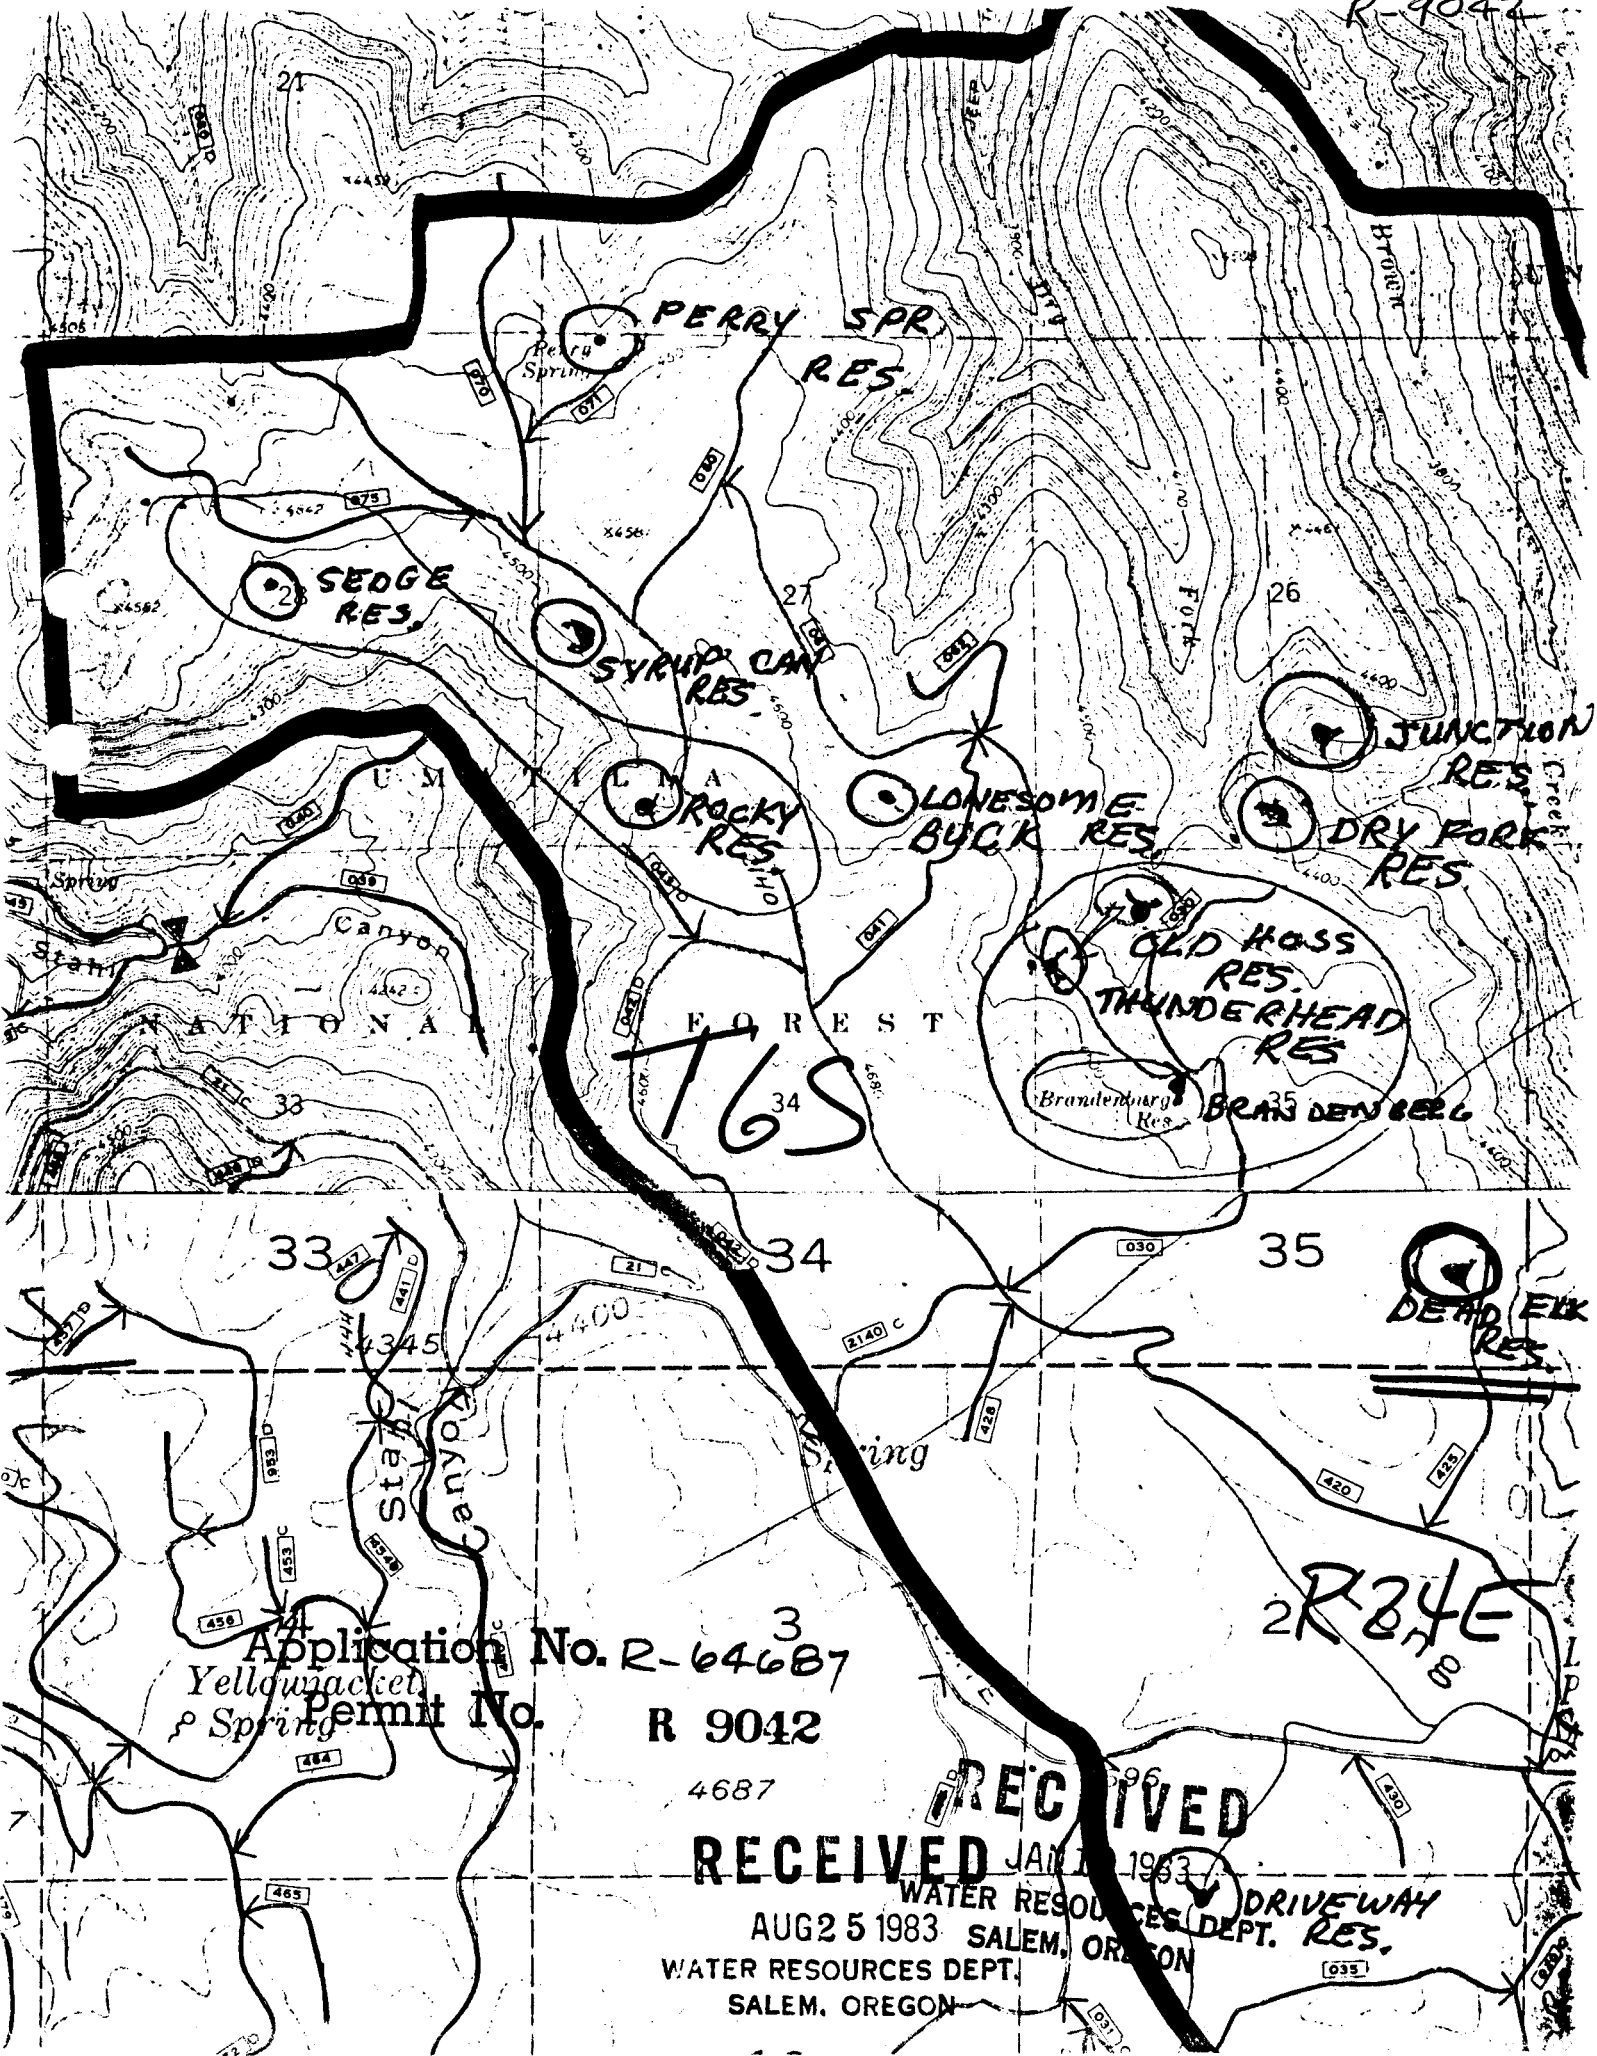

Application No. R-64687
Permit No. R 9042

4687
RECEIVED JAN 10 1983
WATER RESOURCES DEPT. RES.
AUG 25 1983 SALEM, OREGON
WATER RESOURCES DEPT.
SALEM, OREGON