


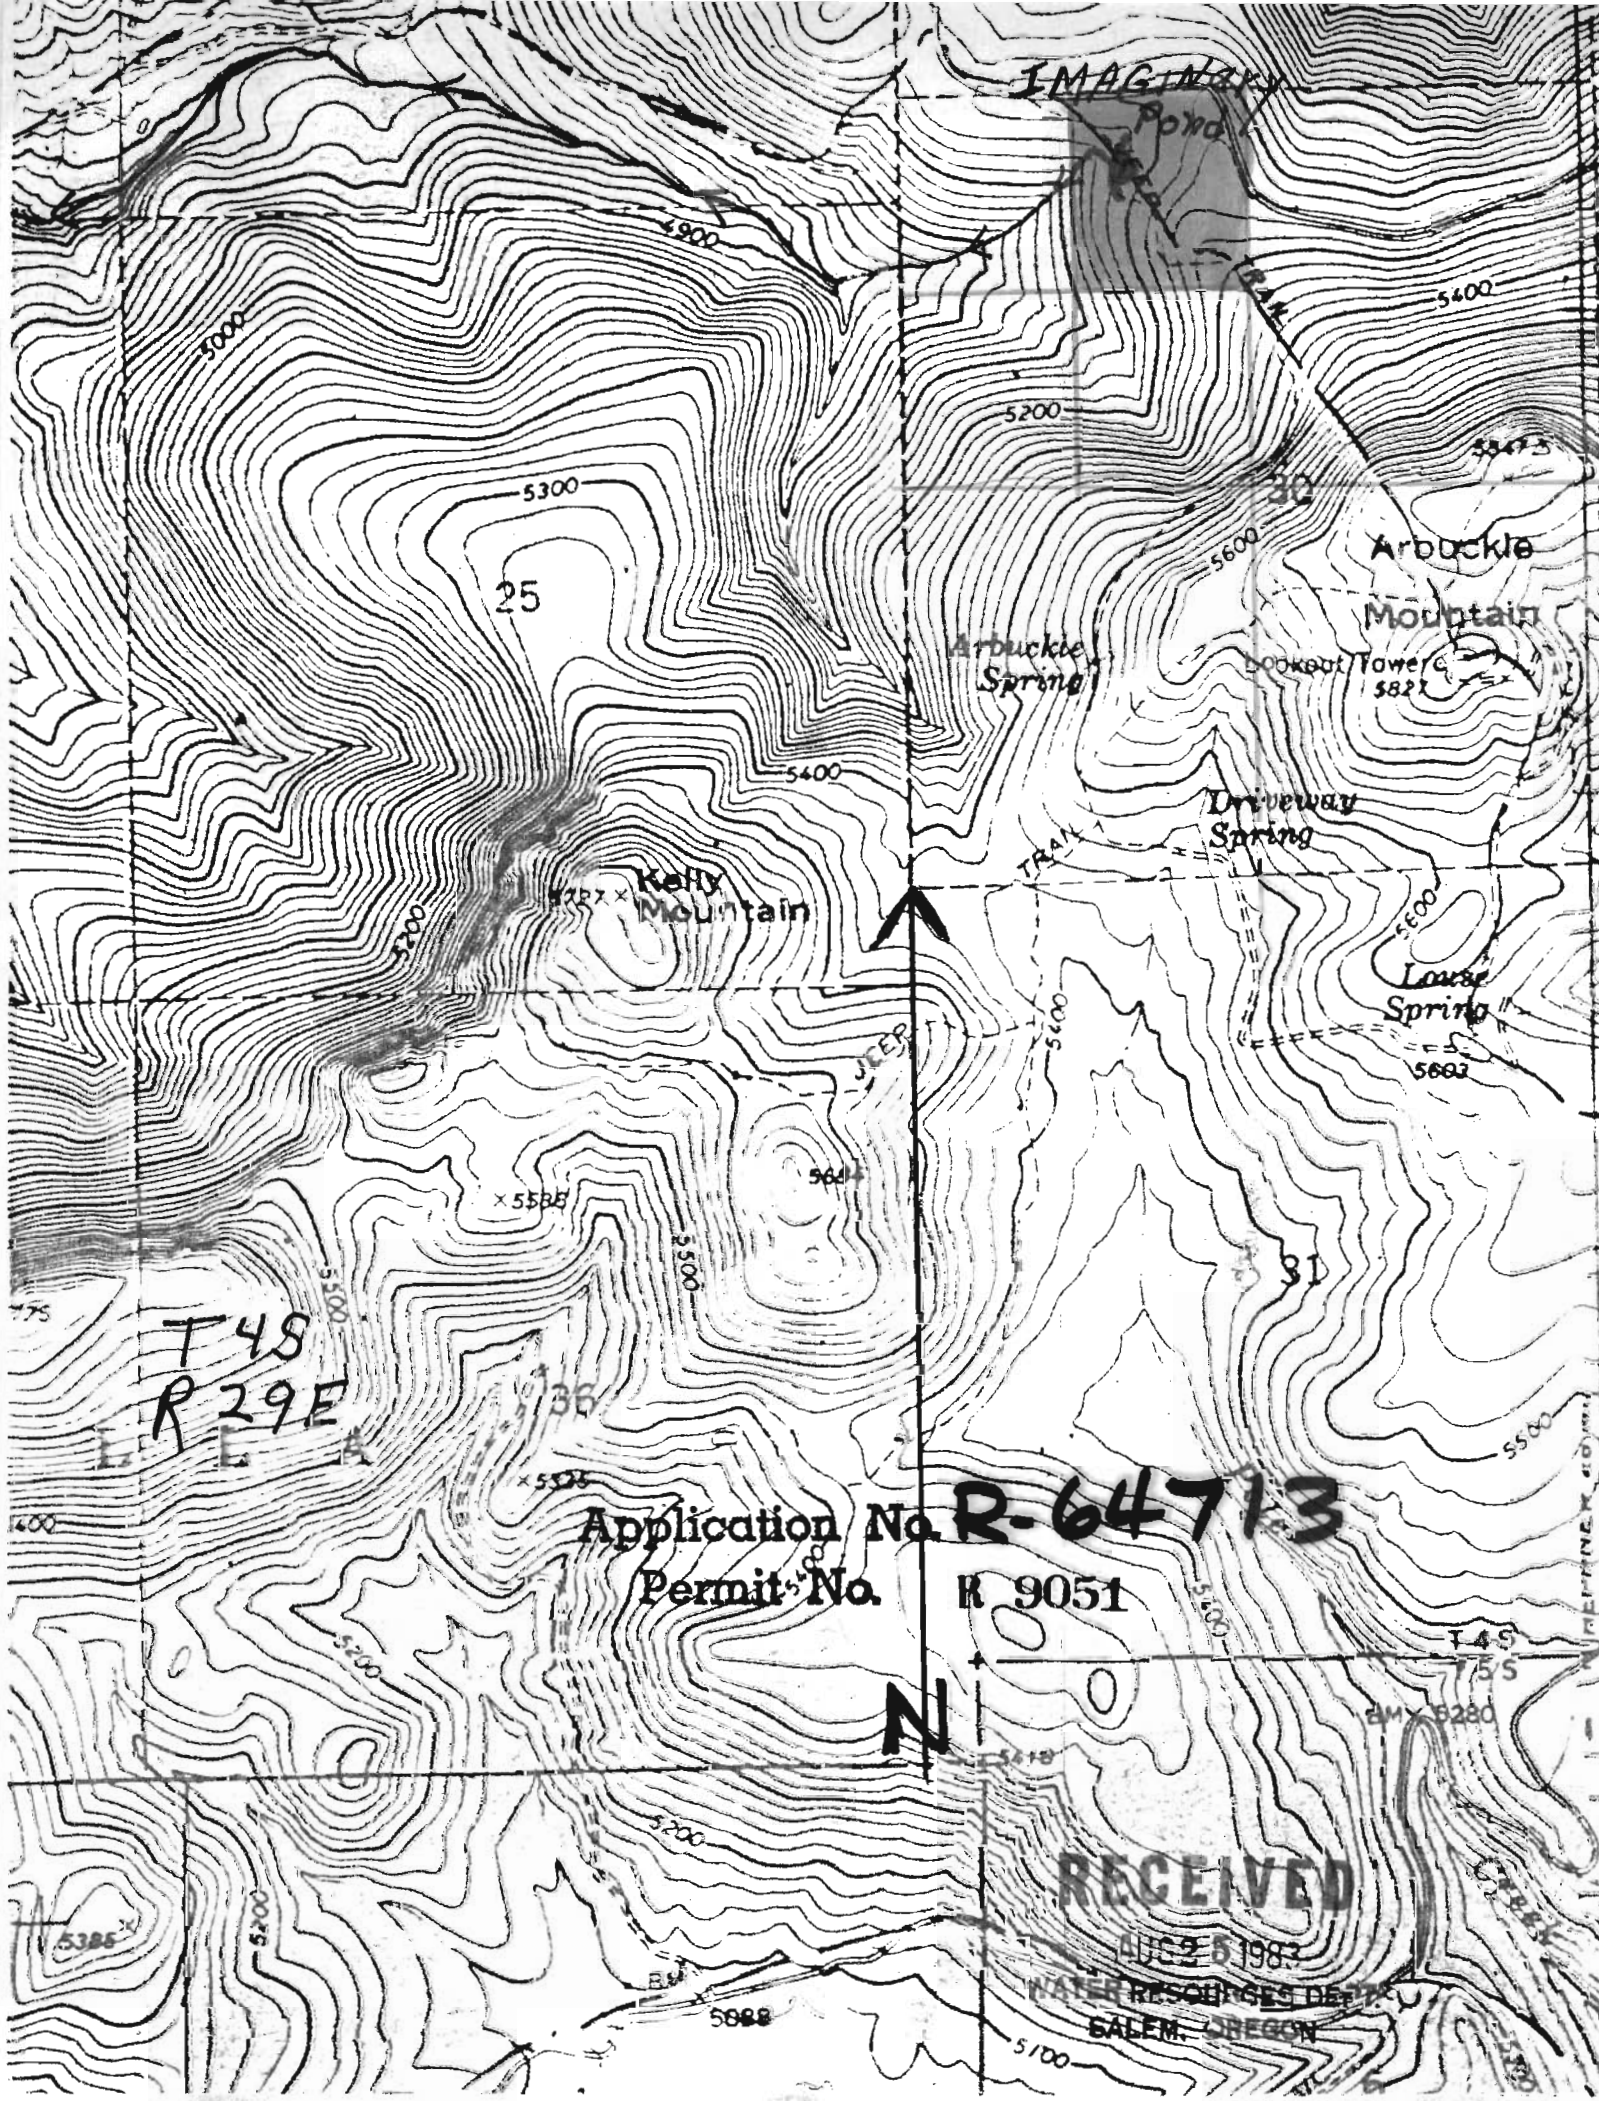

T4S
R29E


Application No. **R-64713**
Permit No. **R 9051**

N

RECEIVED

AUG 25 1983

WATER RESOURCES DEPT.
SALEM, OREGON

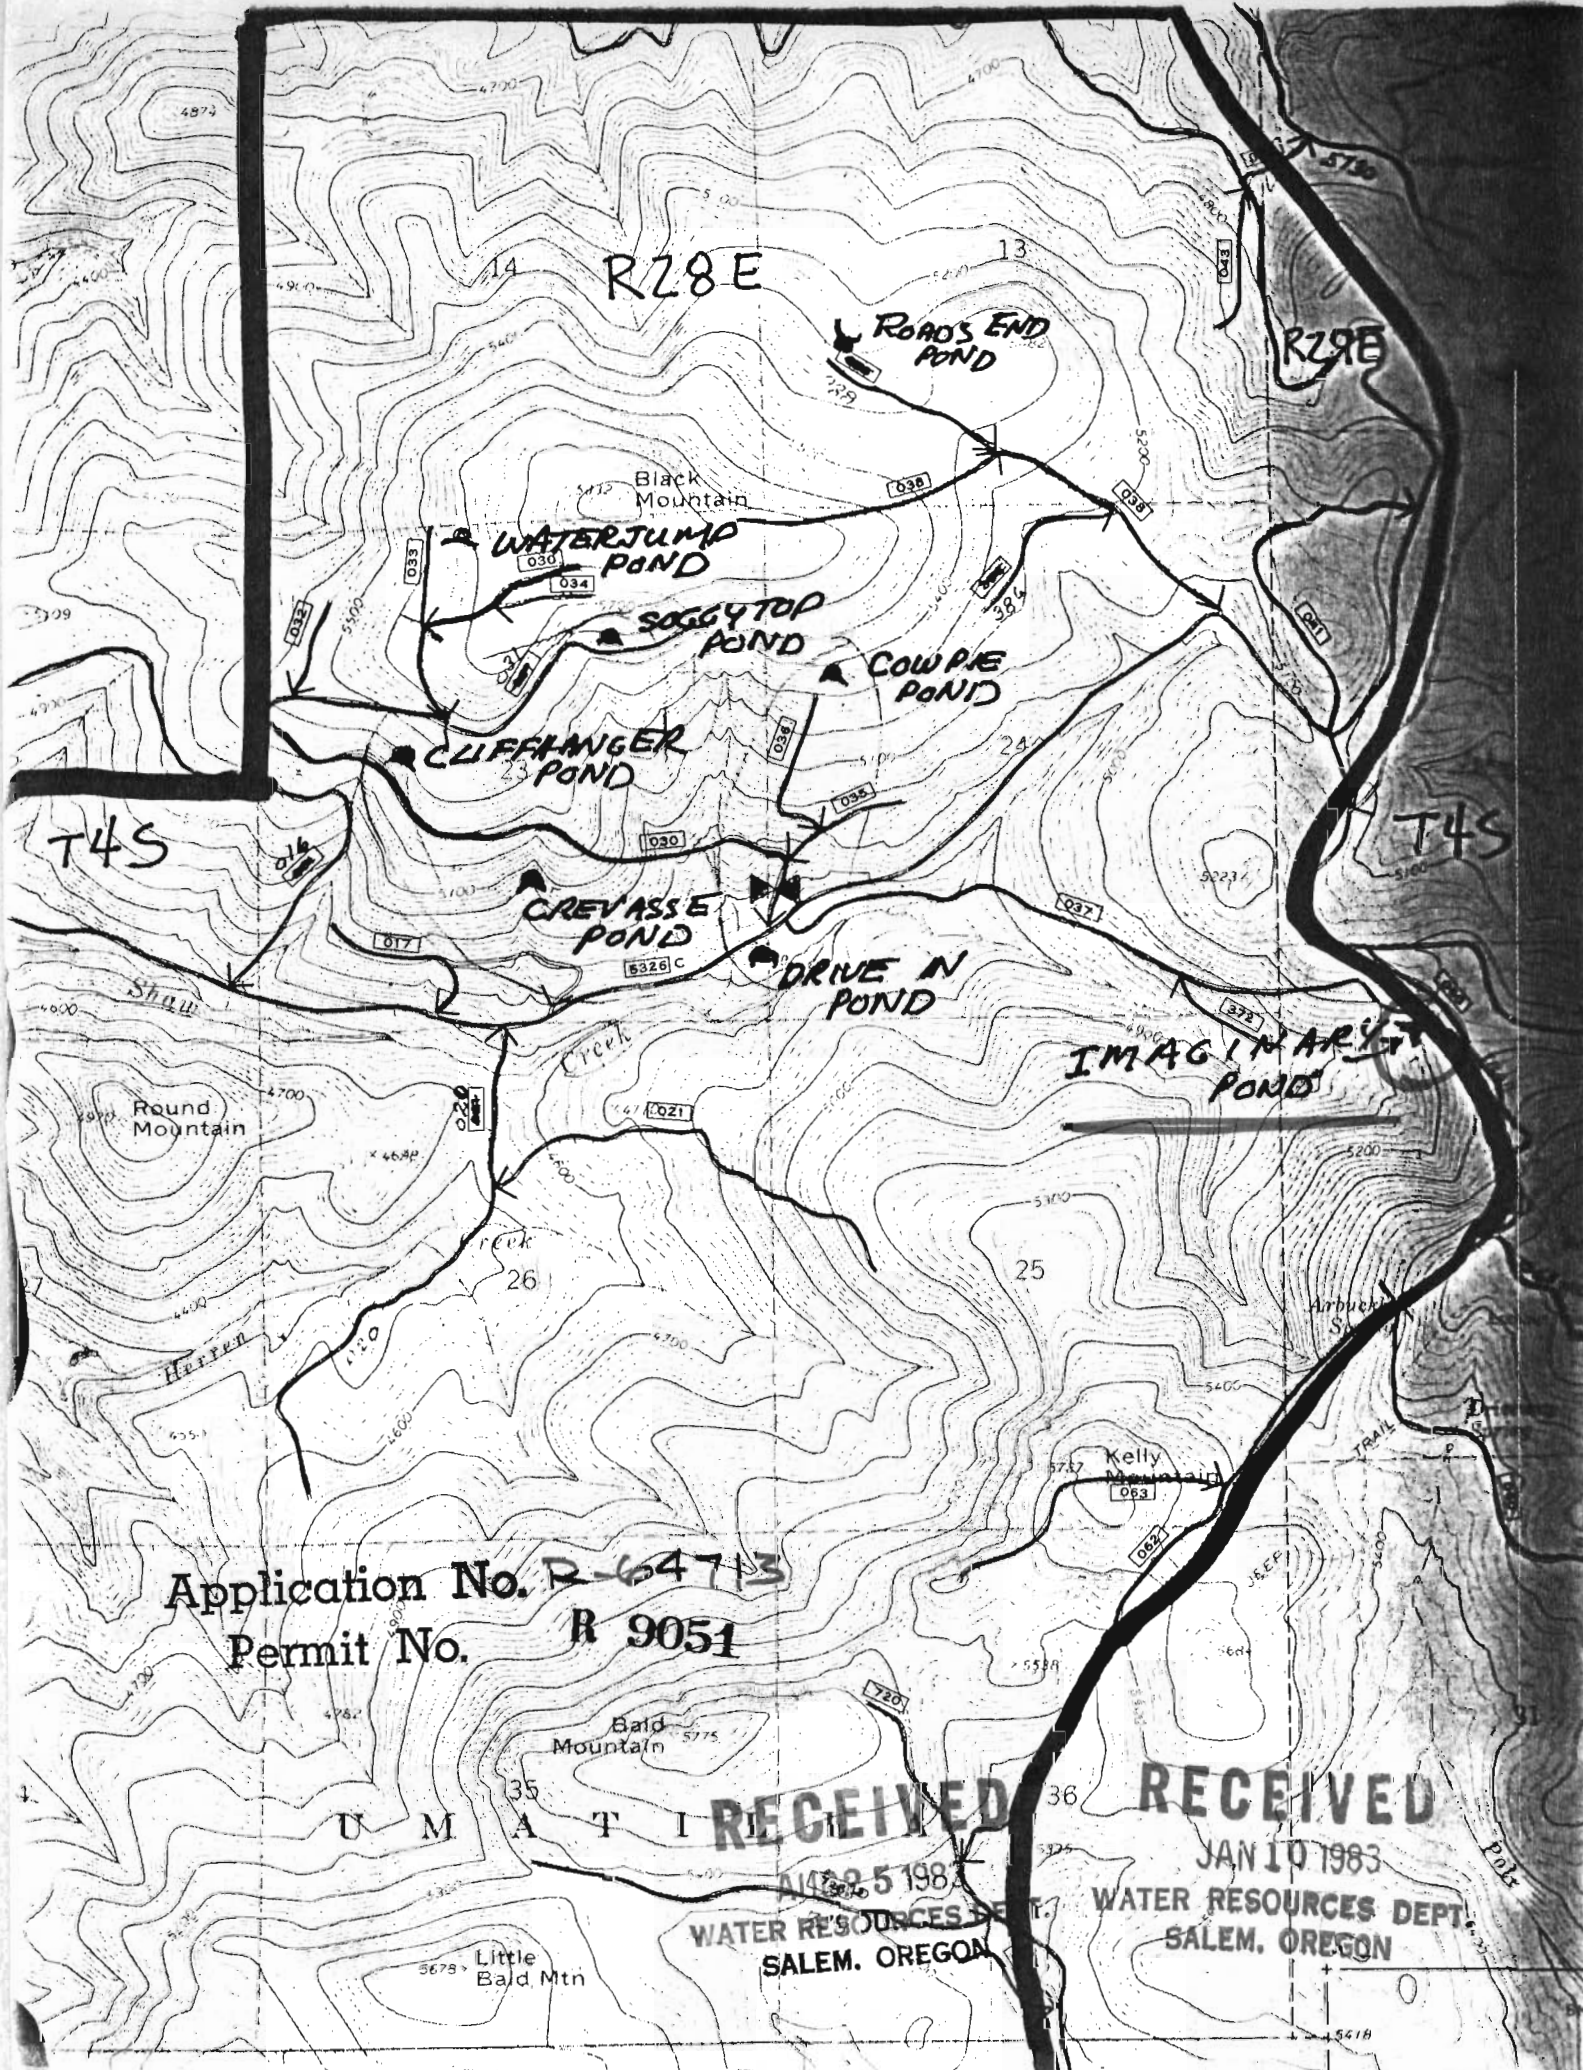

Application No. R-64713
Permit No. R 9051

RECEIVED

WATER RESOURCES DEPT.
SALEM, OREGON

RECEIVED

JAN 10 1983
WATER RESOURCES DEPT.
SALEM, OREGON

