


R-64
R 9087

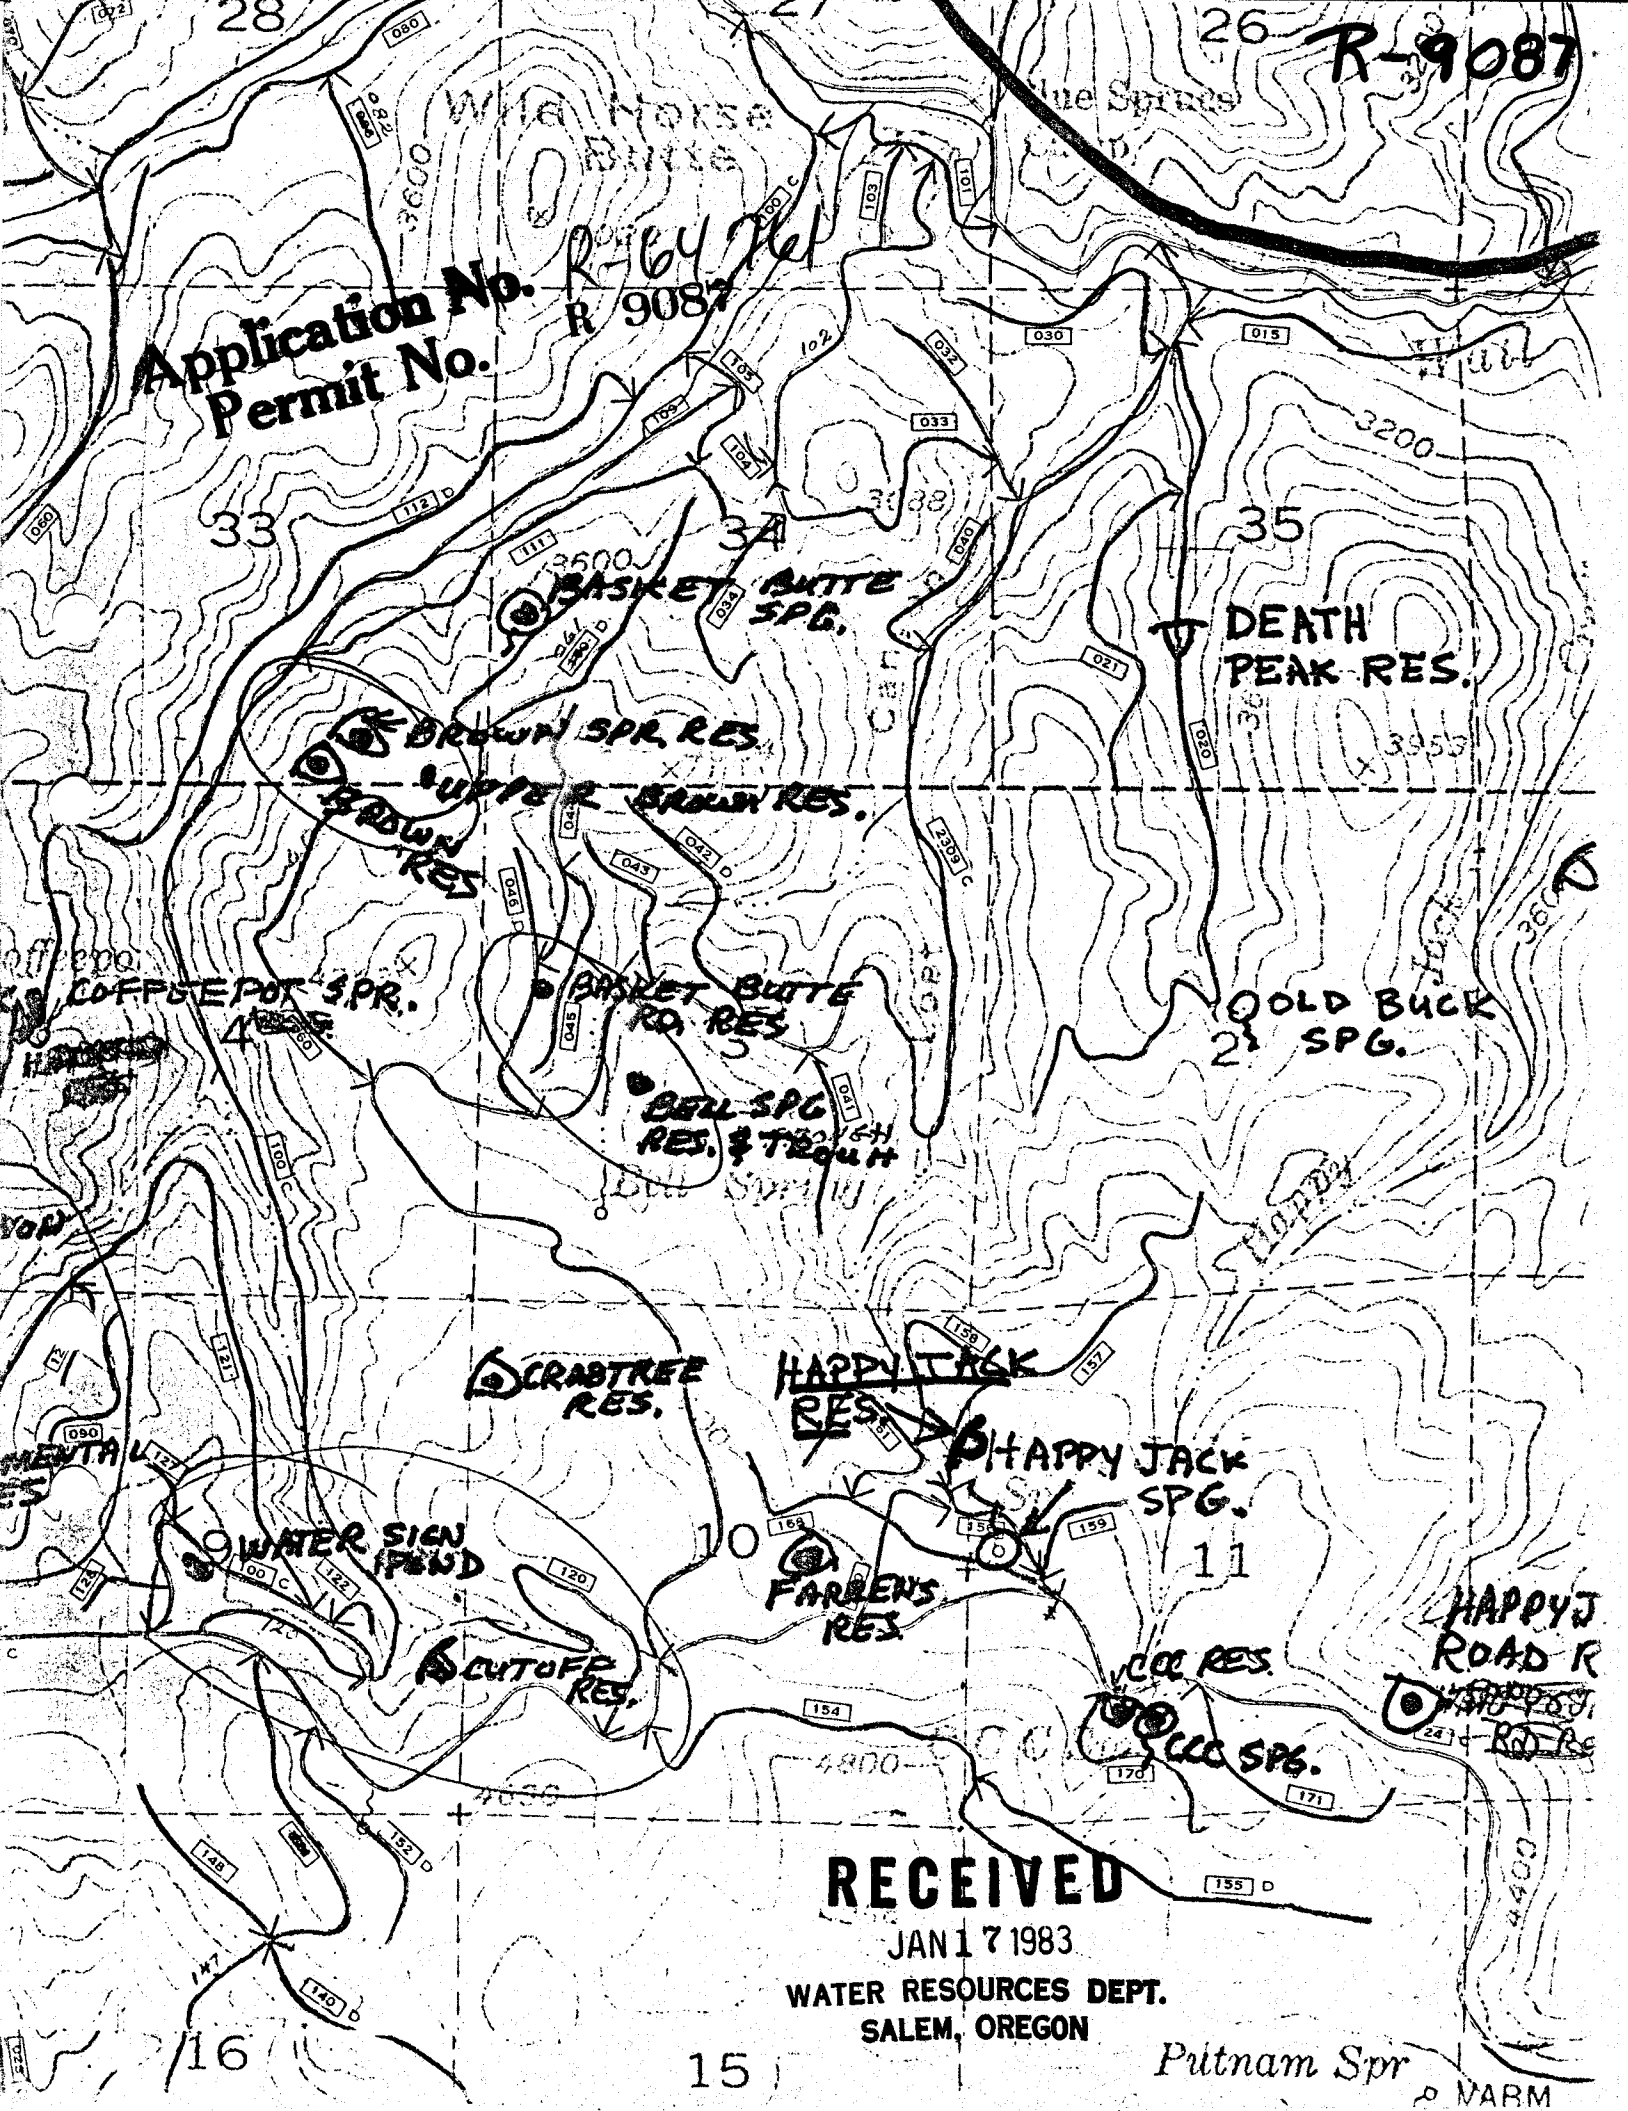

RECEIVED

JAN 17 1983

**WATER RESOURCES DEPT.
SALEM, OREGON**

Putnam Spr

ARM