


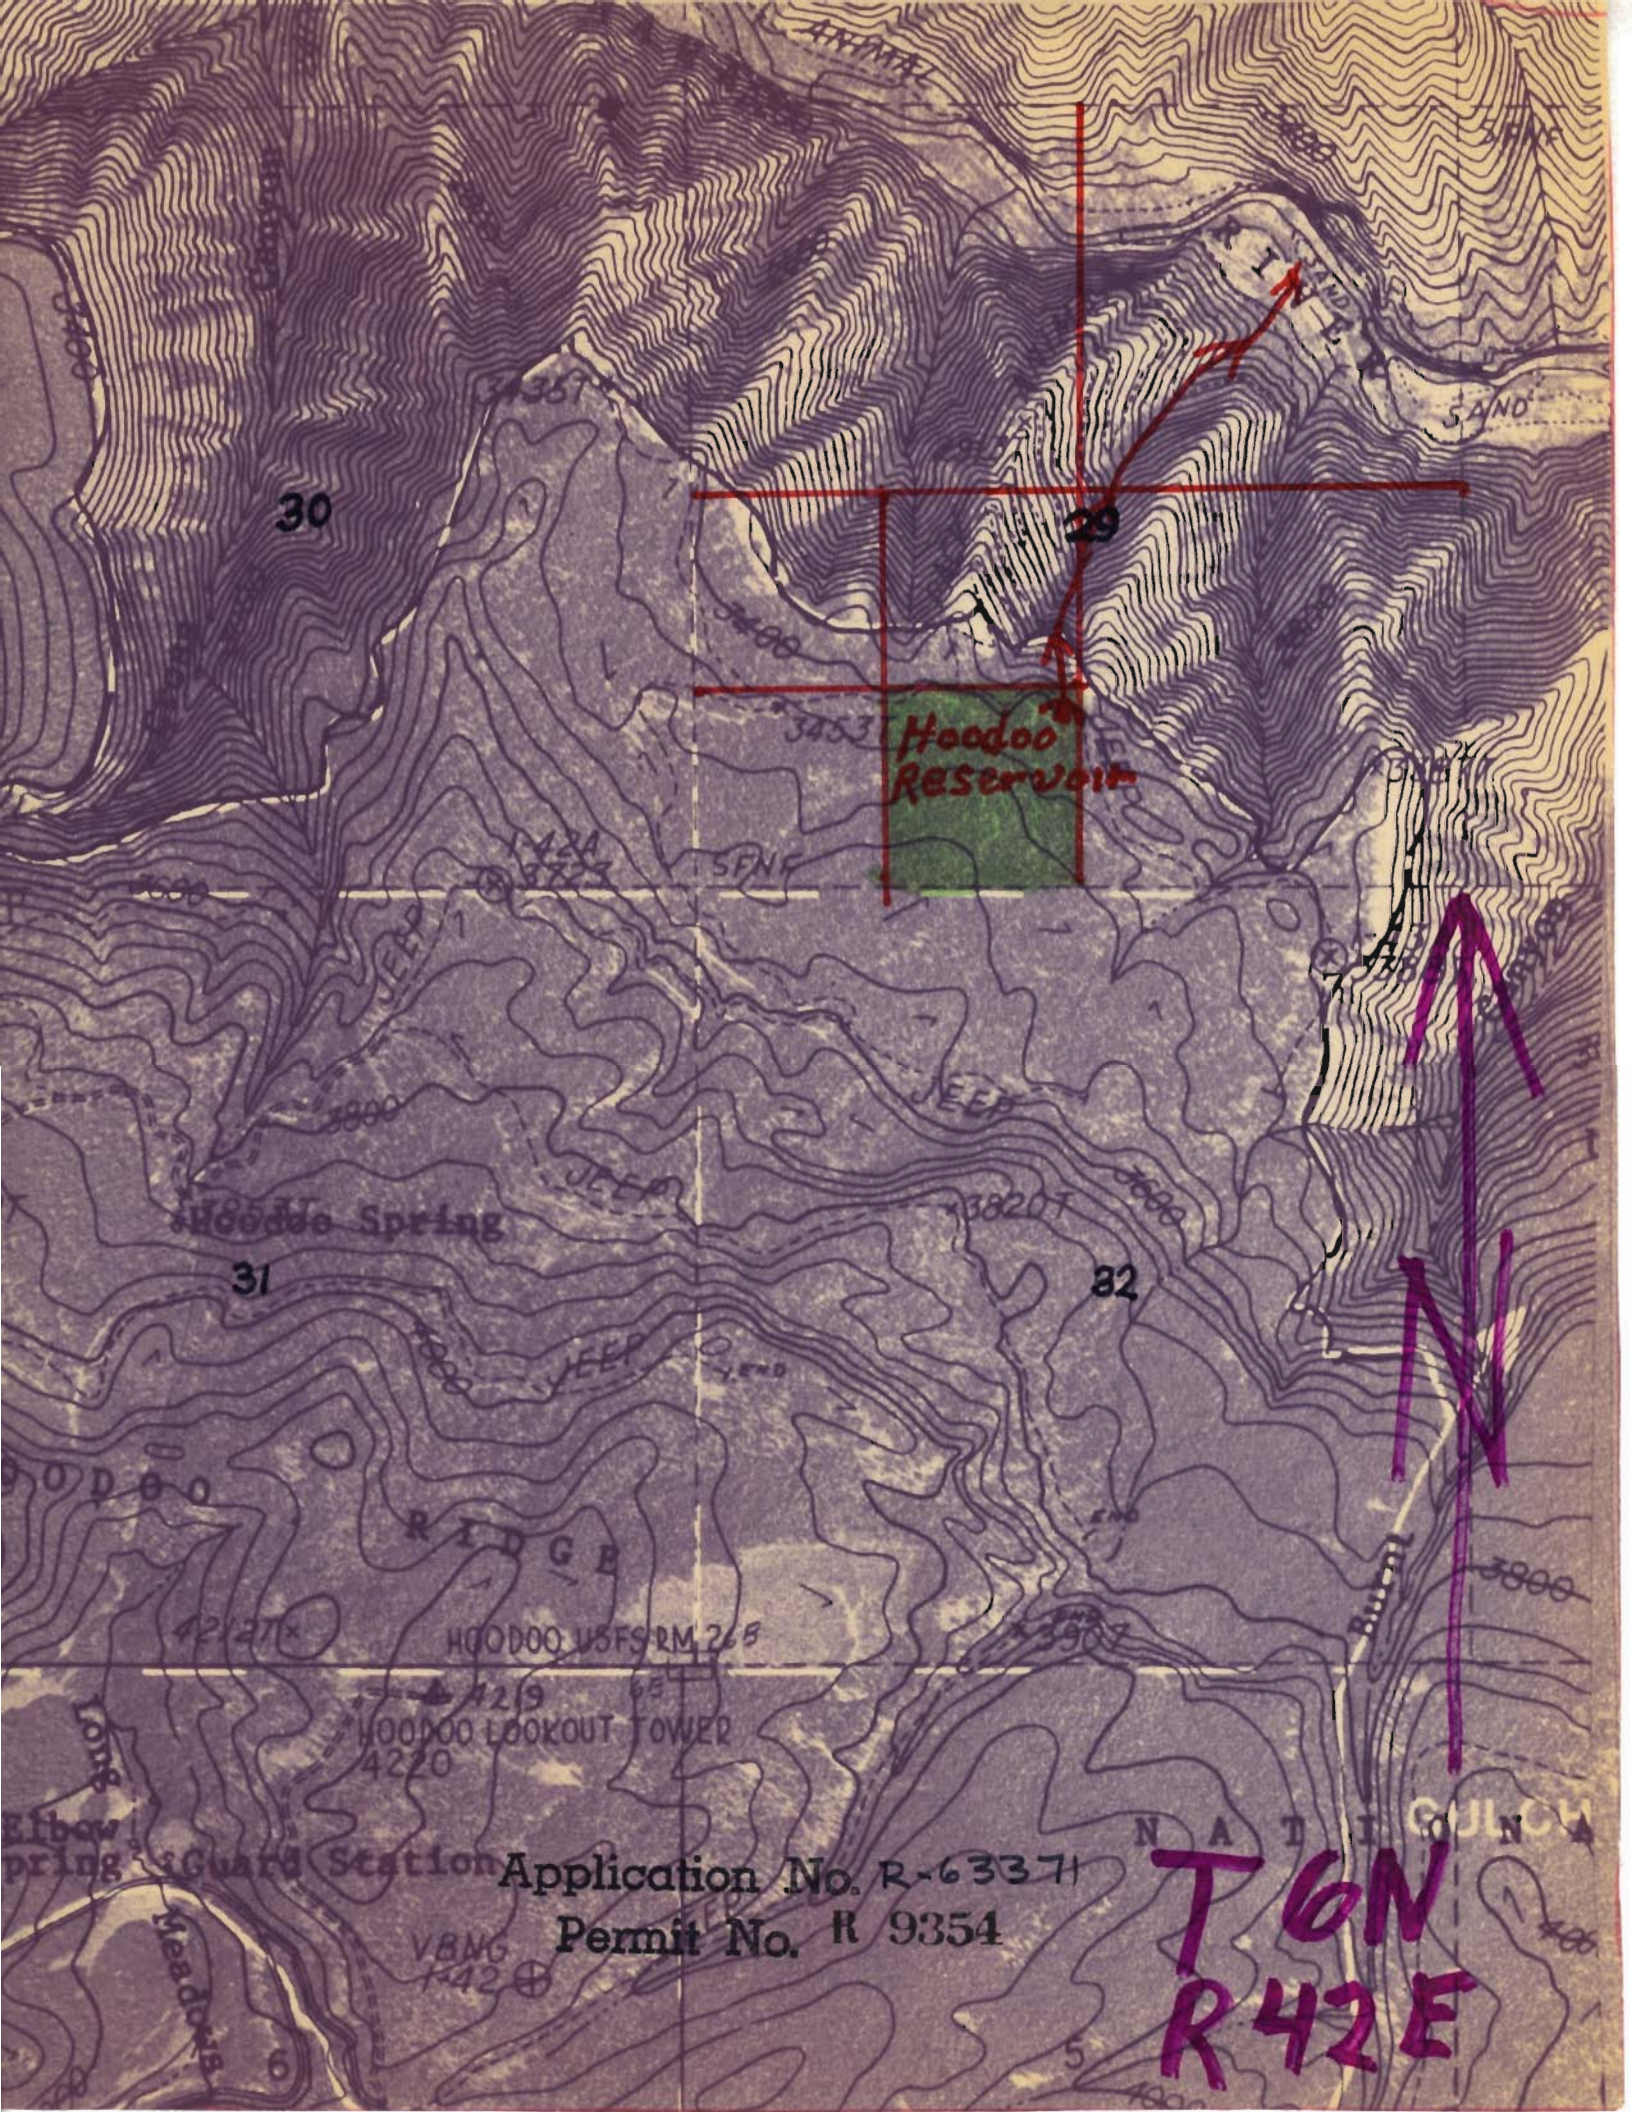

30

29

Hoodoo Reservoir

Hoodoo Spring

31

32

HOODOO RIDGE

HOODOO USFS RM 265

HOODOO LOOKOUT TOWER
4220

Elbow Spring Guard Station

Application No. R-63371

Permit No. R 9354

N A T I O N A L

T 6 N
R 42 E