


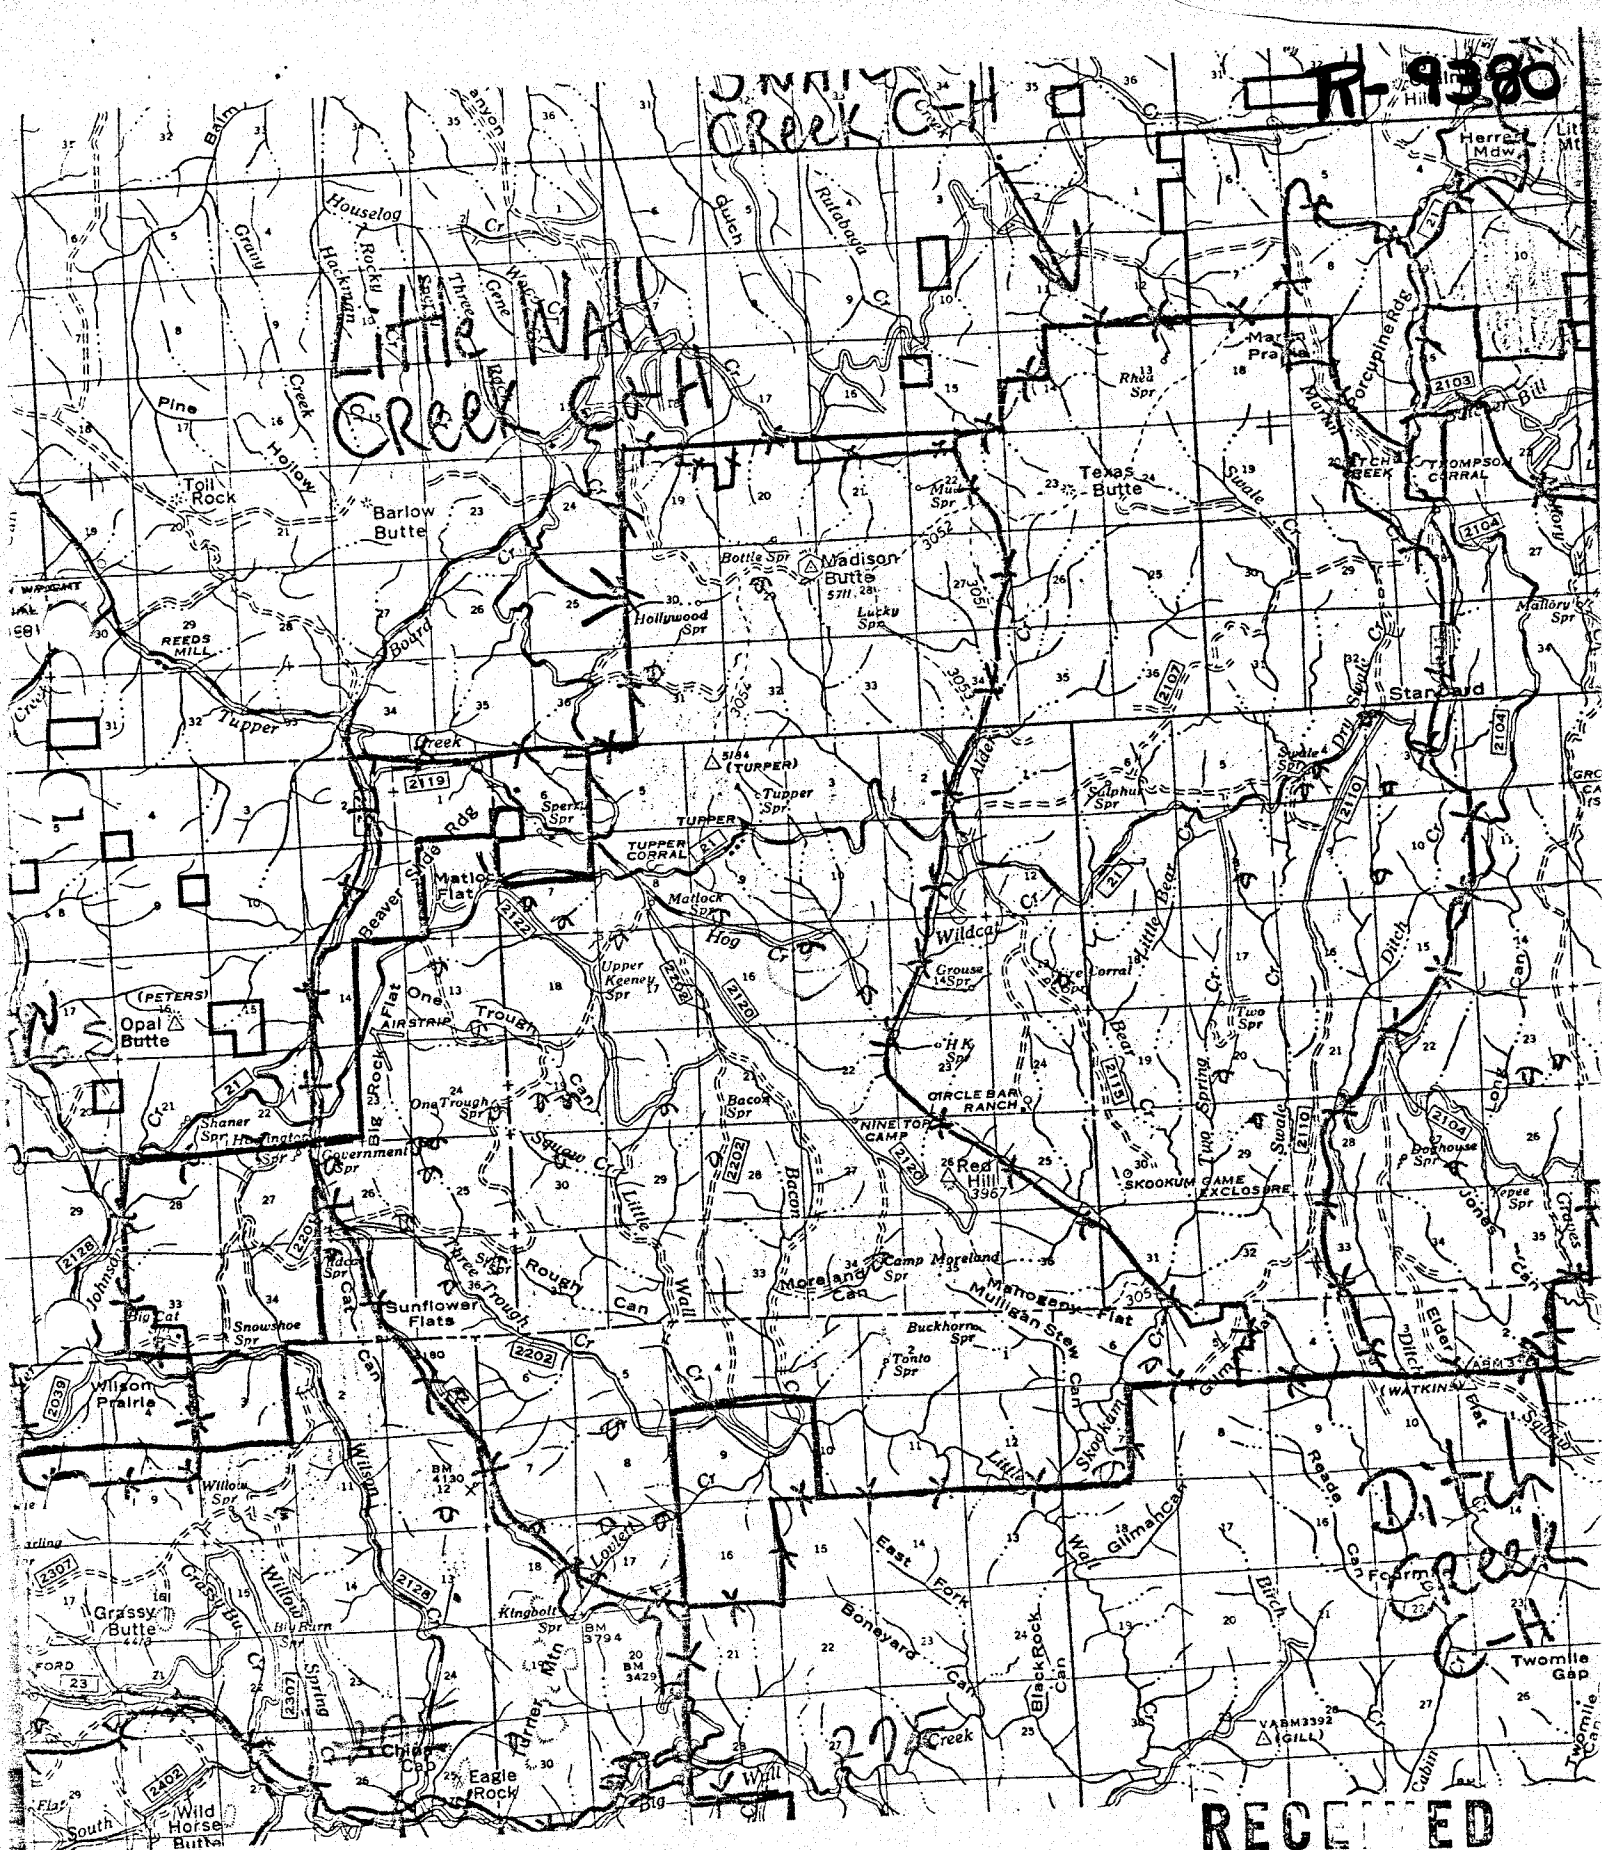

Application No. R-63670
Permit No. R 9380

RECEIVED
JUN 16 1982
WATER RESOURCES DEPT
SALEM, OREGON