


Township 1 South - 12E,

Range 6732

*Map of G. E. Manchester*

6732

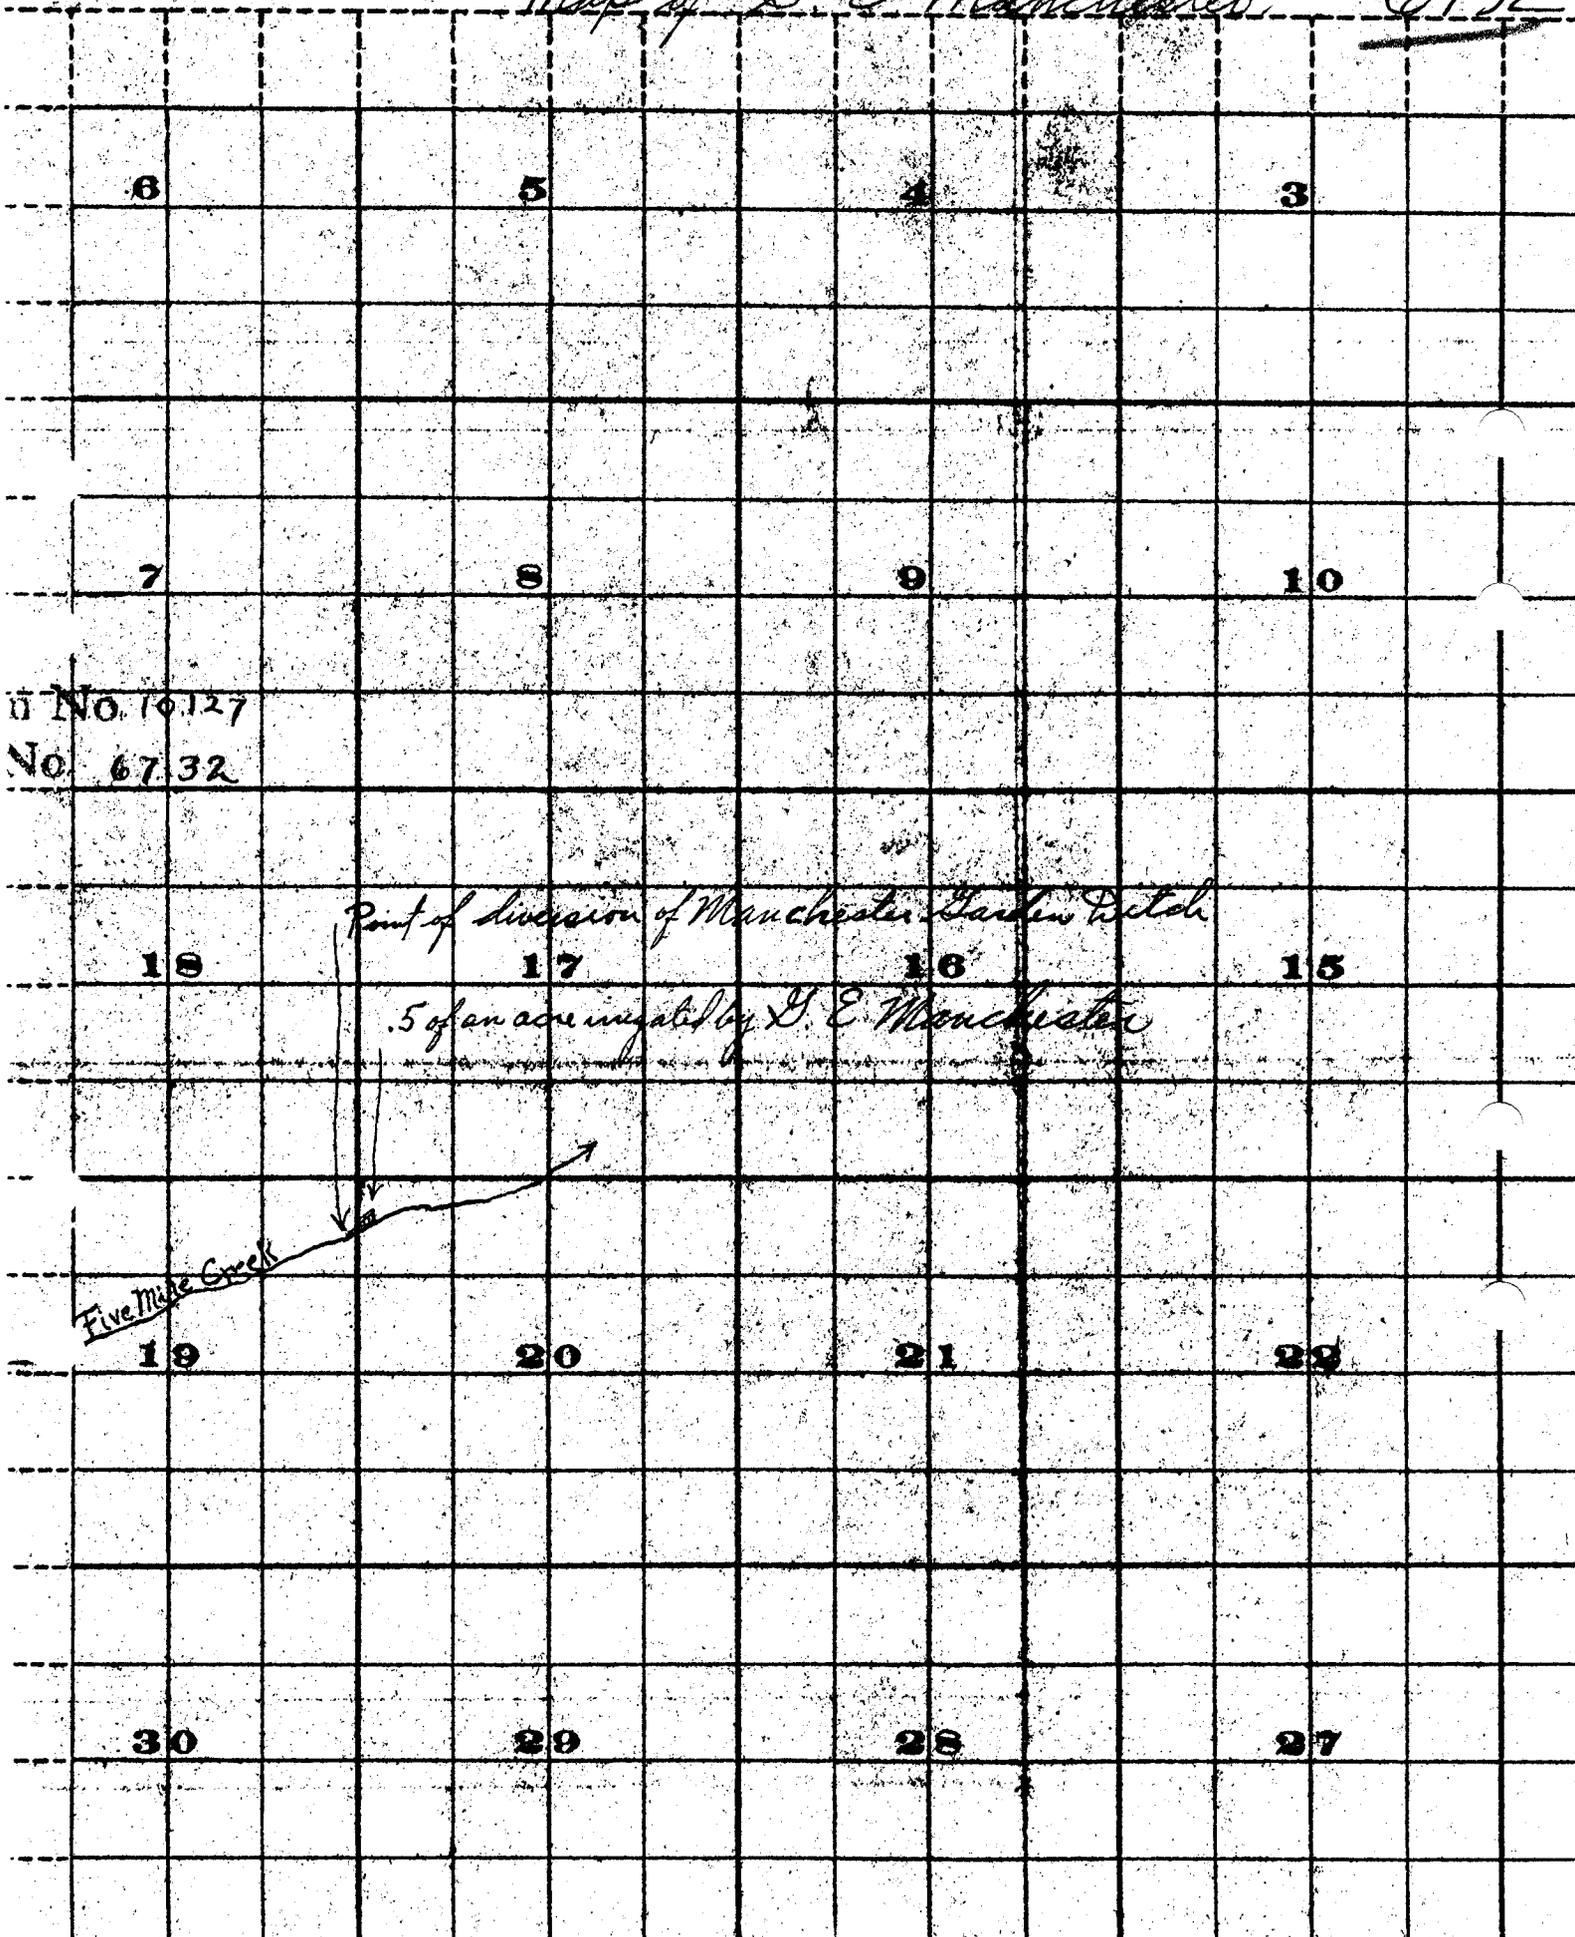

No. 10127

No. 6732

*Point of division of Manchester Garden Ditch*

*.5 of an acre irrigated by G. E. Manchester*

*Five Mile Creek*