


R-9543 4331
1 OF 2

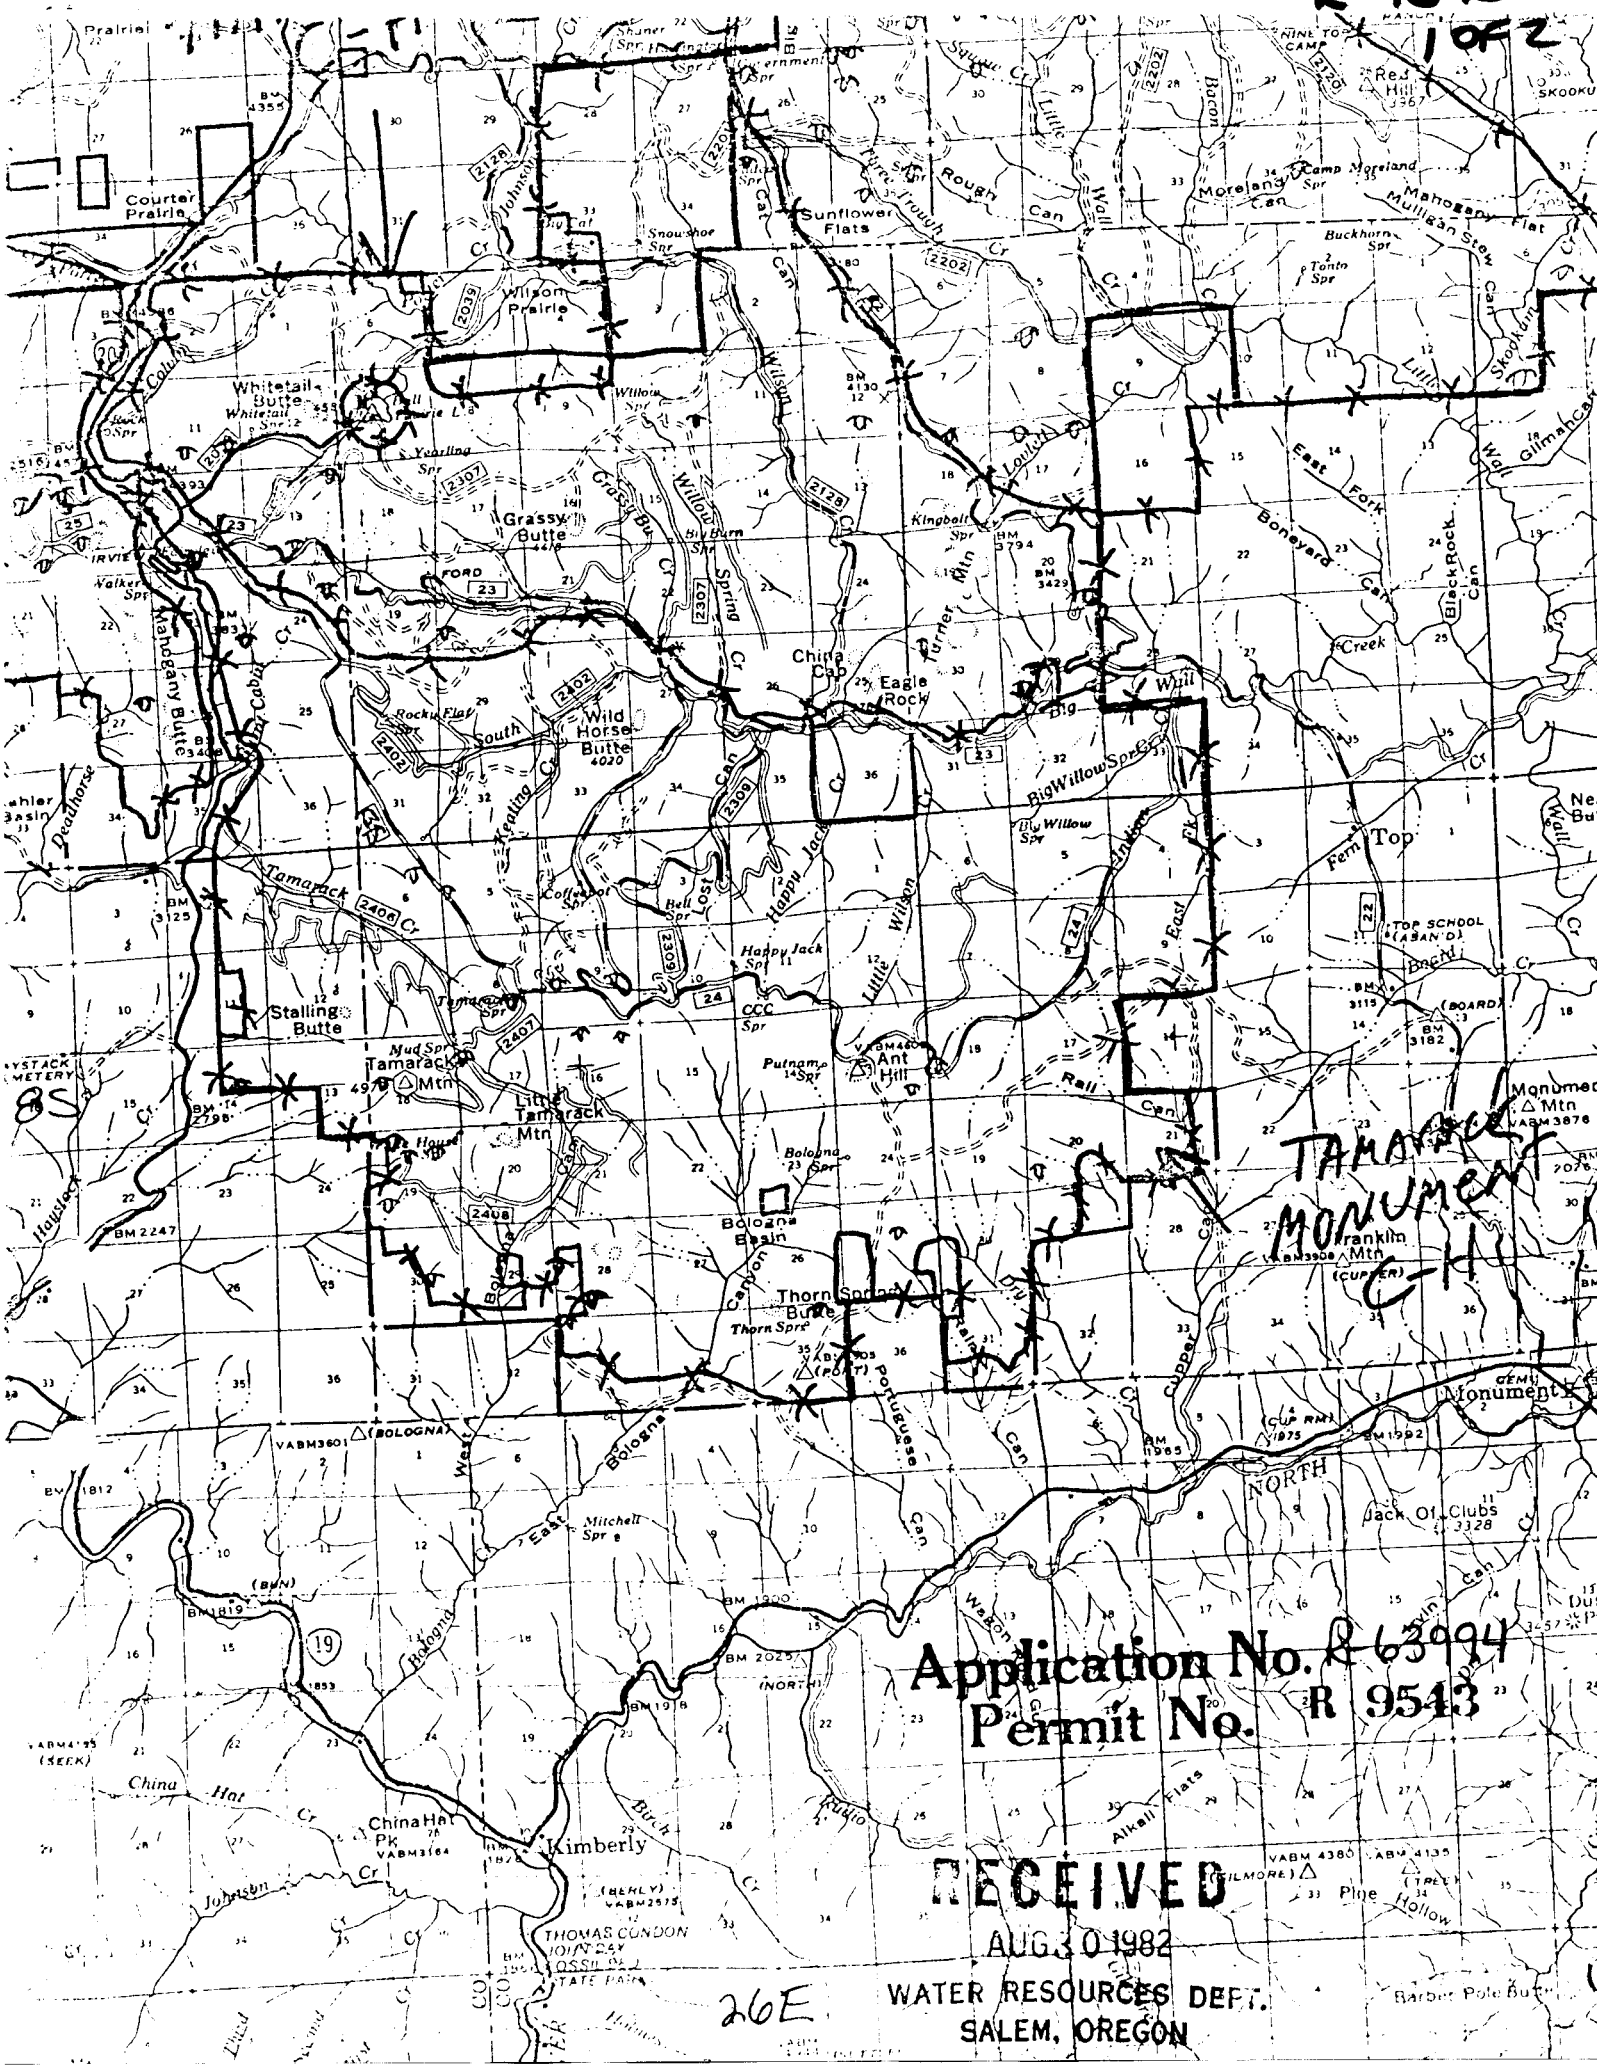

Application No. R 63994
Permit No. R 9543

RECEIVED

AUG 30 1982

WATER RESOURCES DEPT.
SALEM, OREGON

26E

Application No.

R-63994

R-9543

2022

Permit No.

R 9543

T 8 S

R 26 E

Section 28

