



61338 R-9550
1042

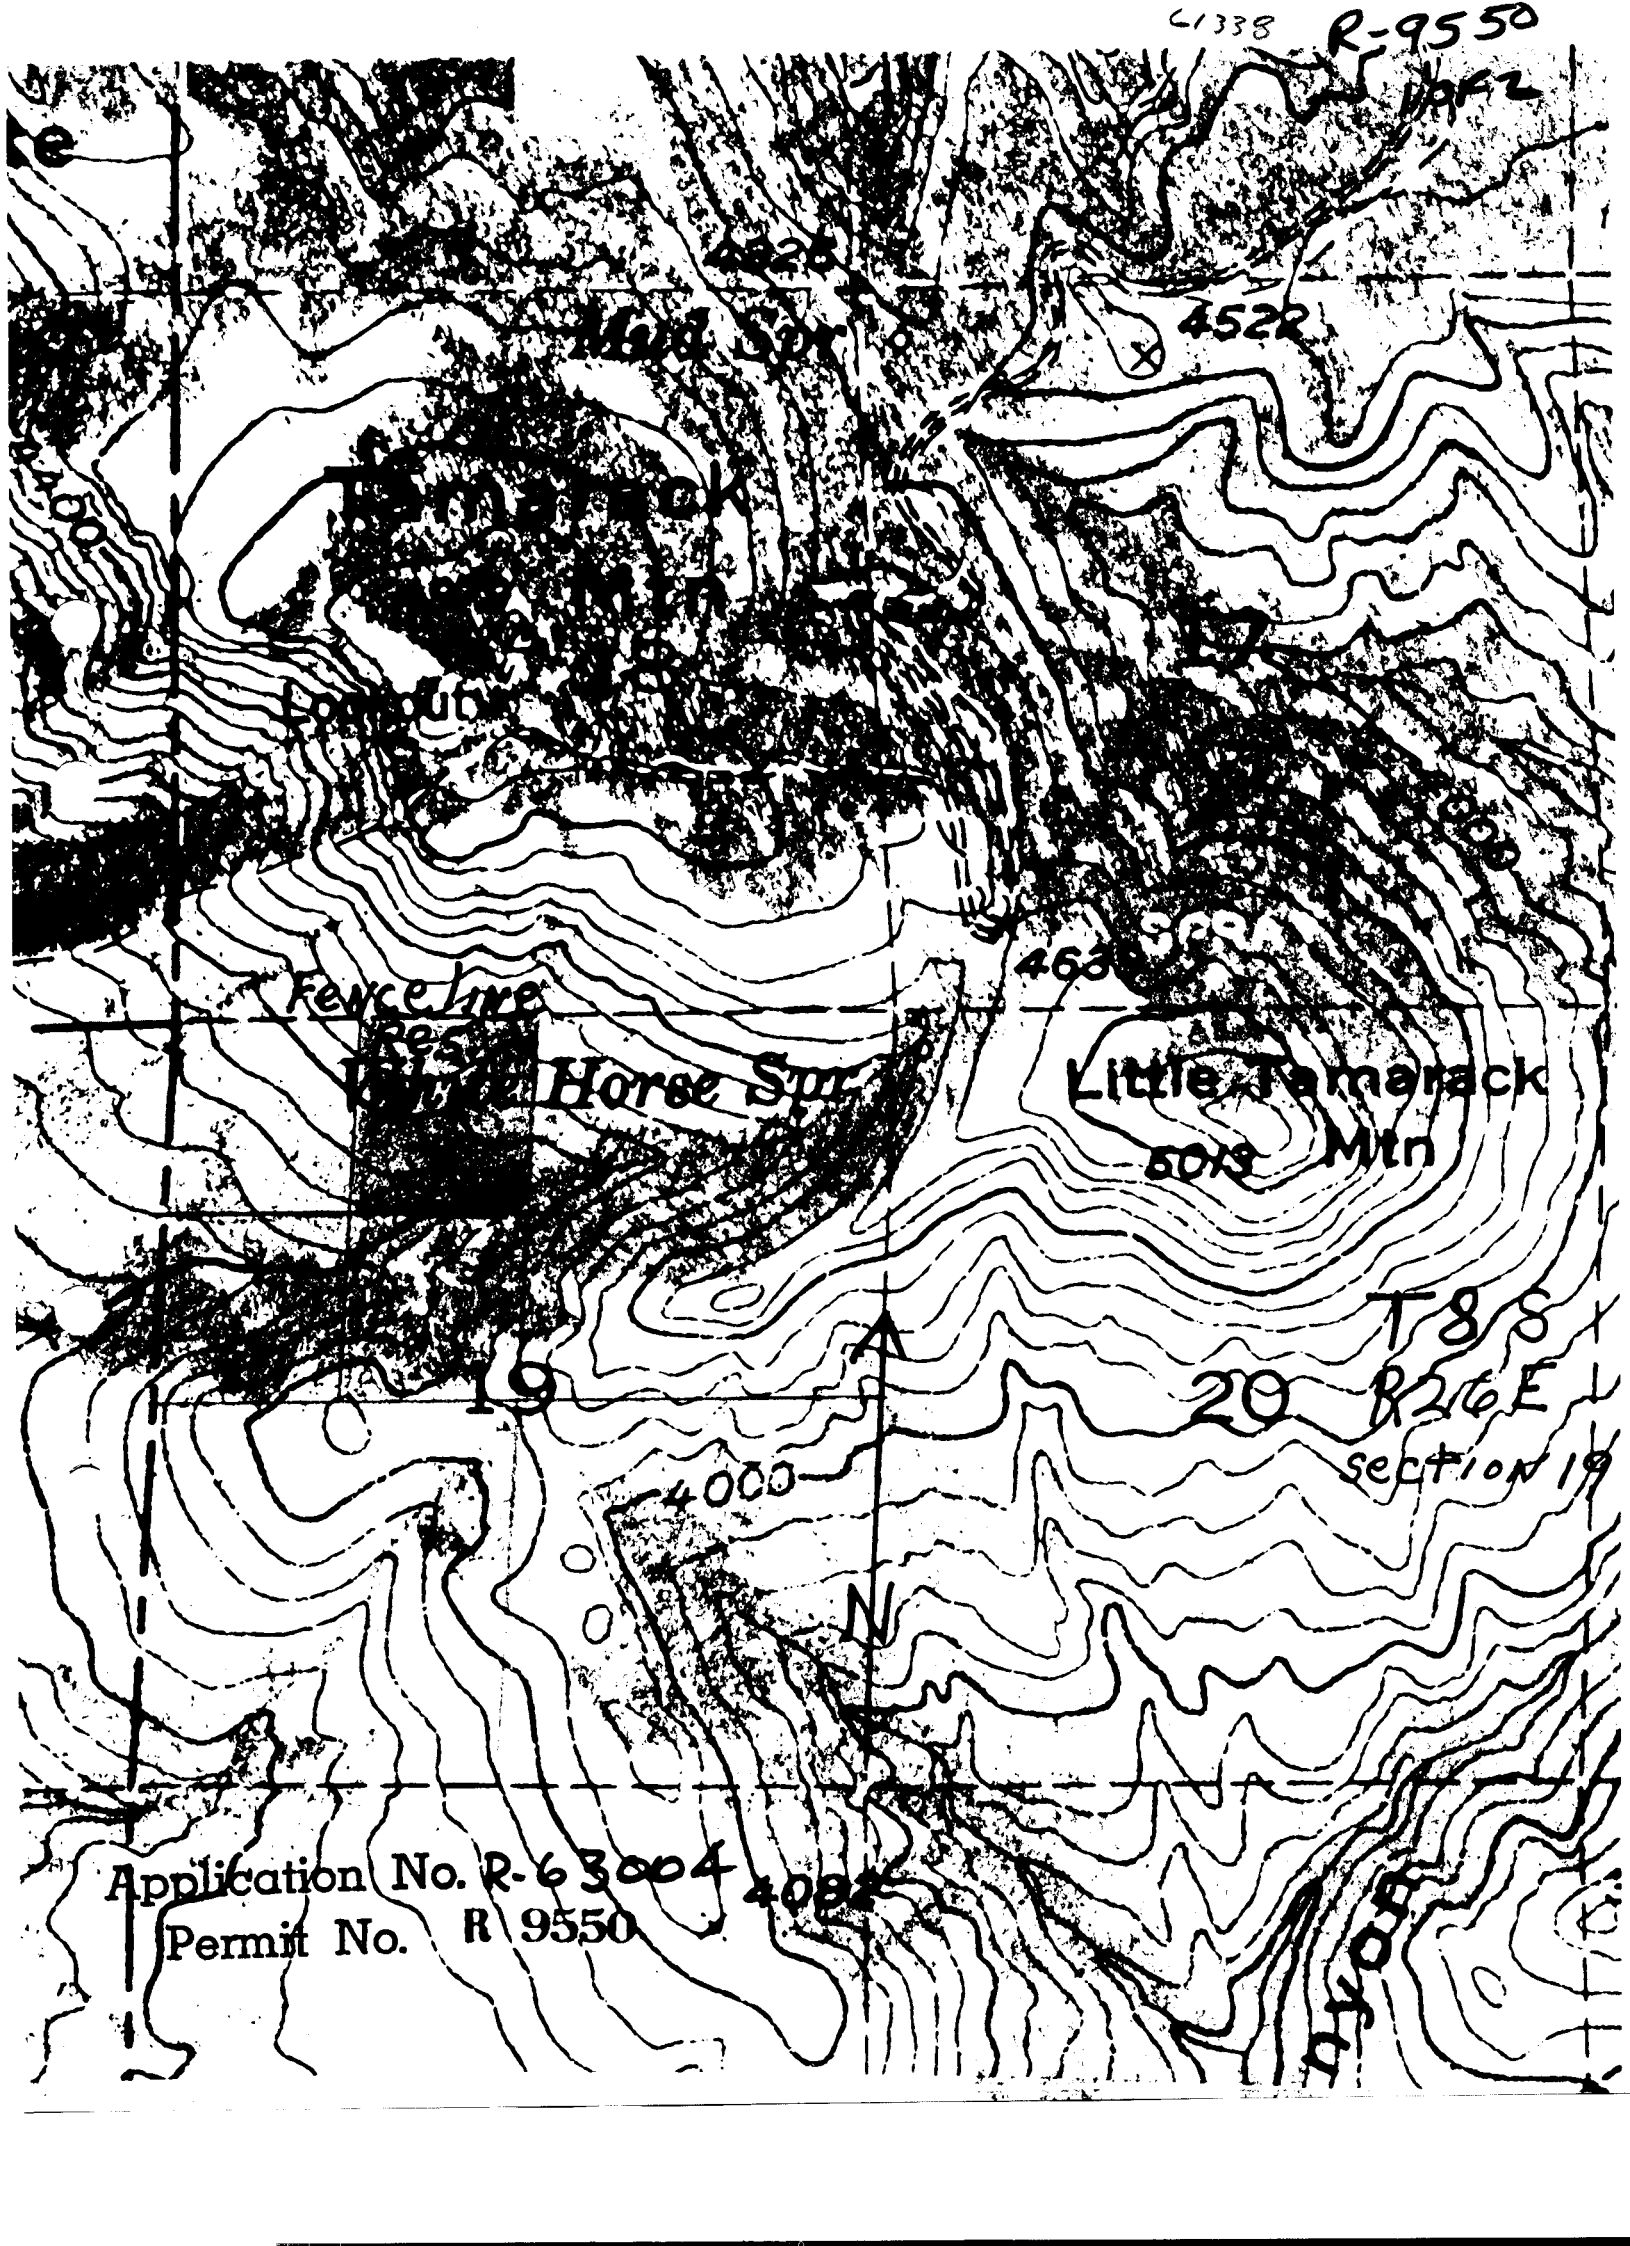

Application No. R-63004 4092
Permit No. R 9550

R-9550

2047

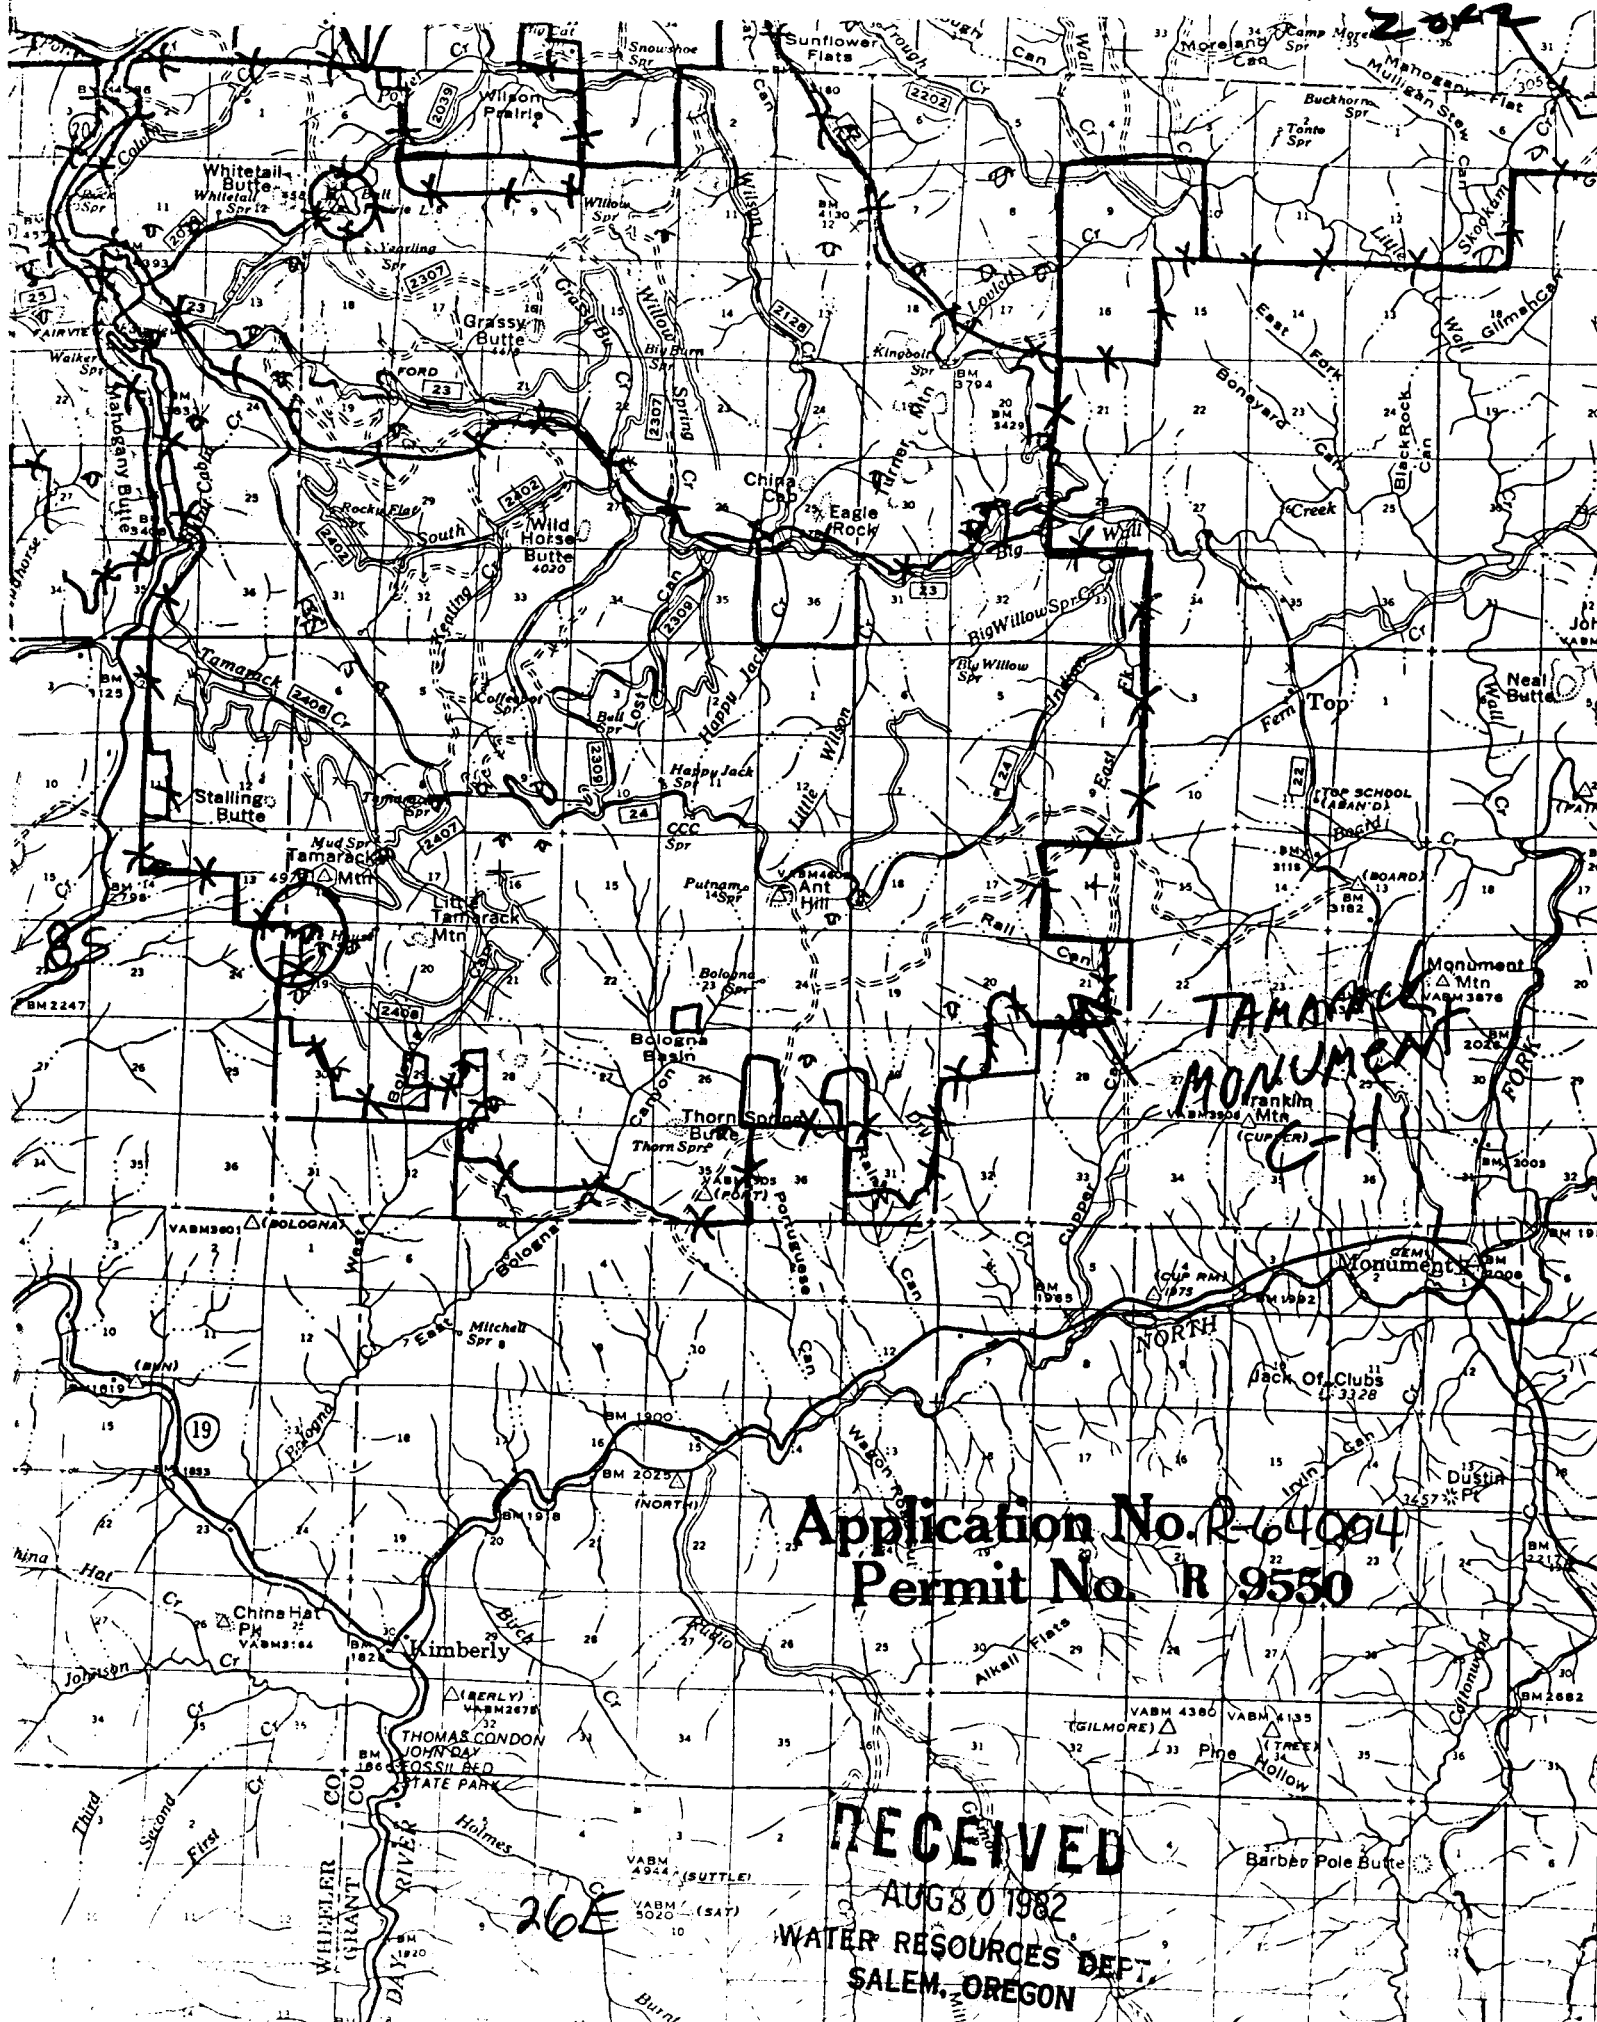

TAMARACK
MONUMENT
C-H

Application No. R-64094
Permit No. R 9550

RECEIVED

AUG 30 1982

WATER RESOURCES DEPT.
SALEM, OREGON

26E