

R-9555


2 OF 2

19°30'

22°30'

28E

15'

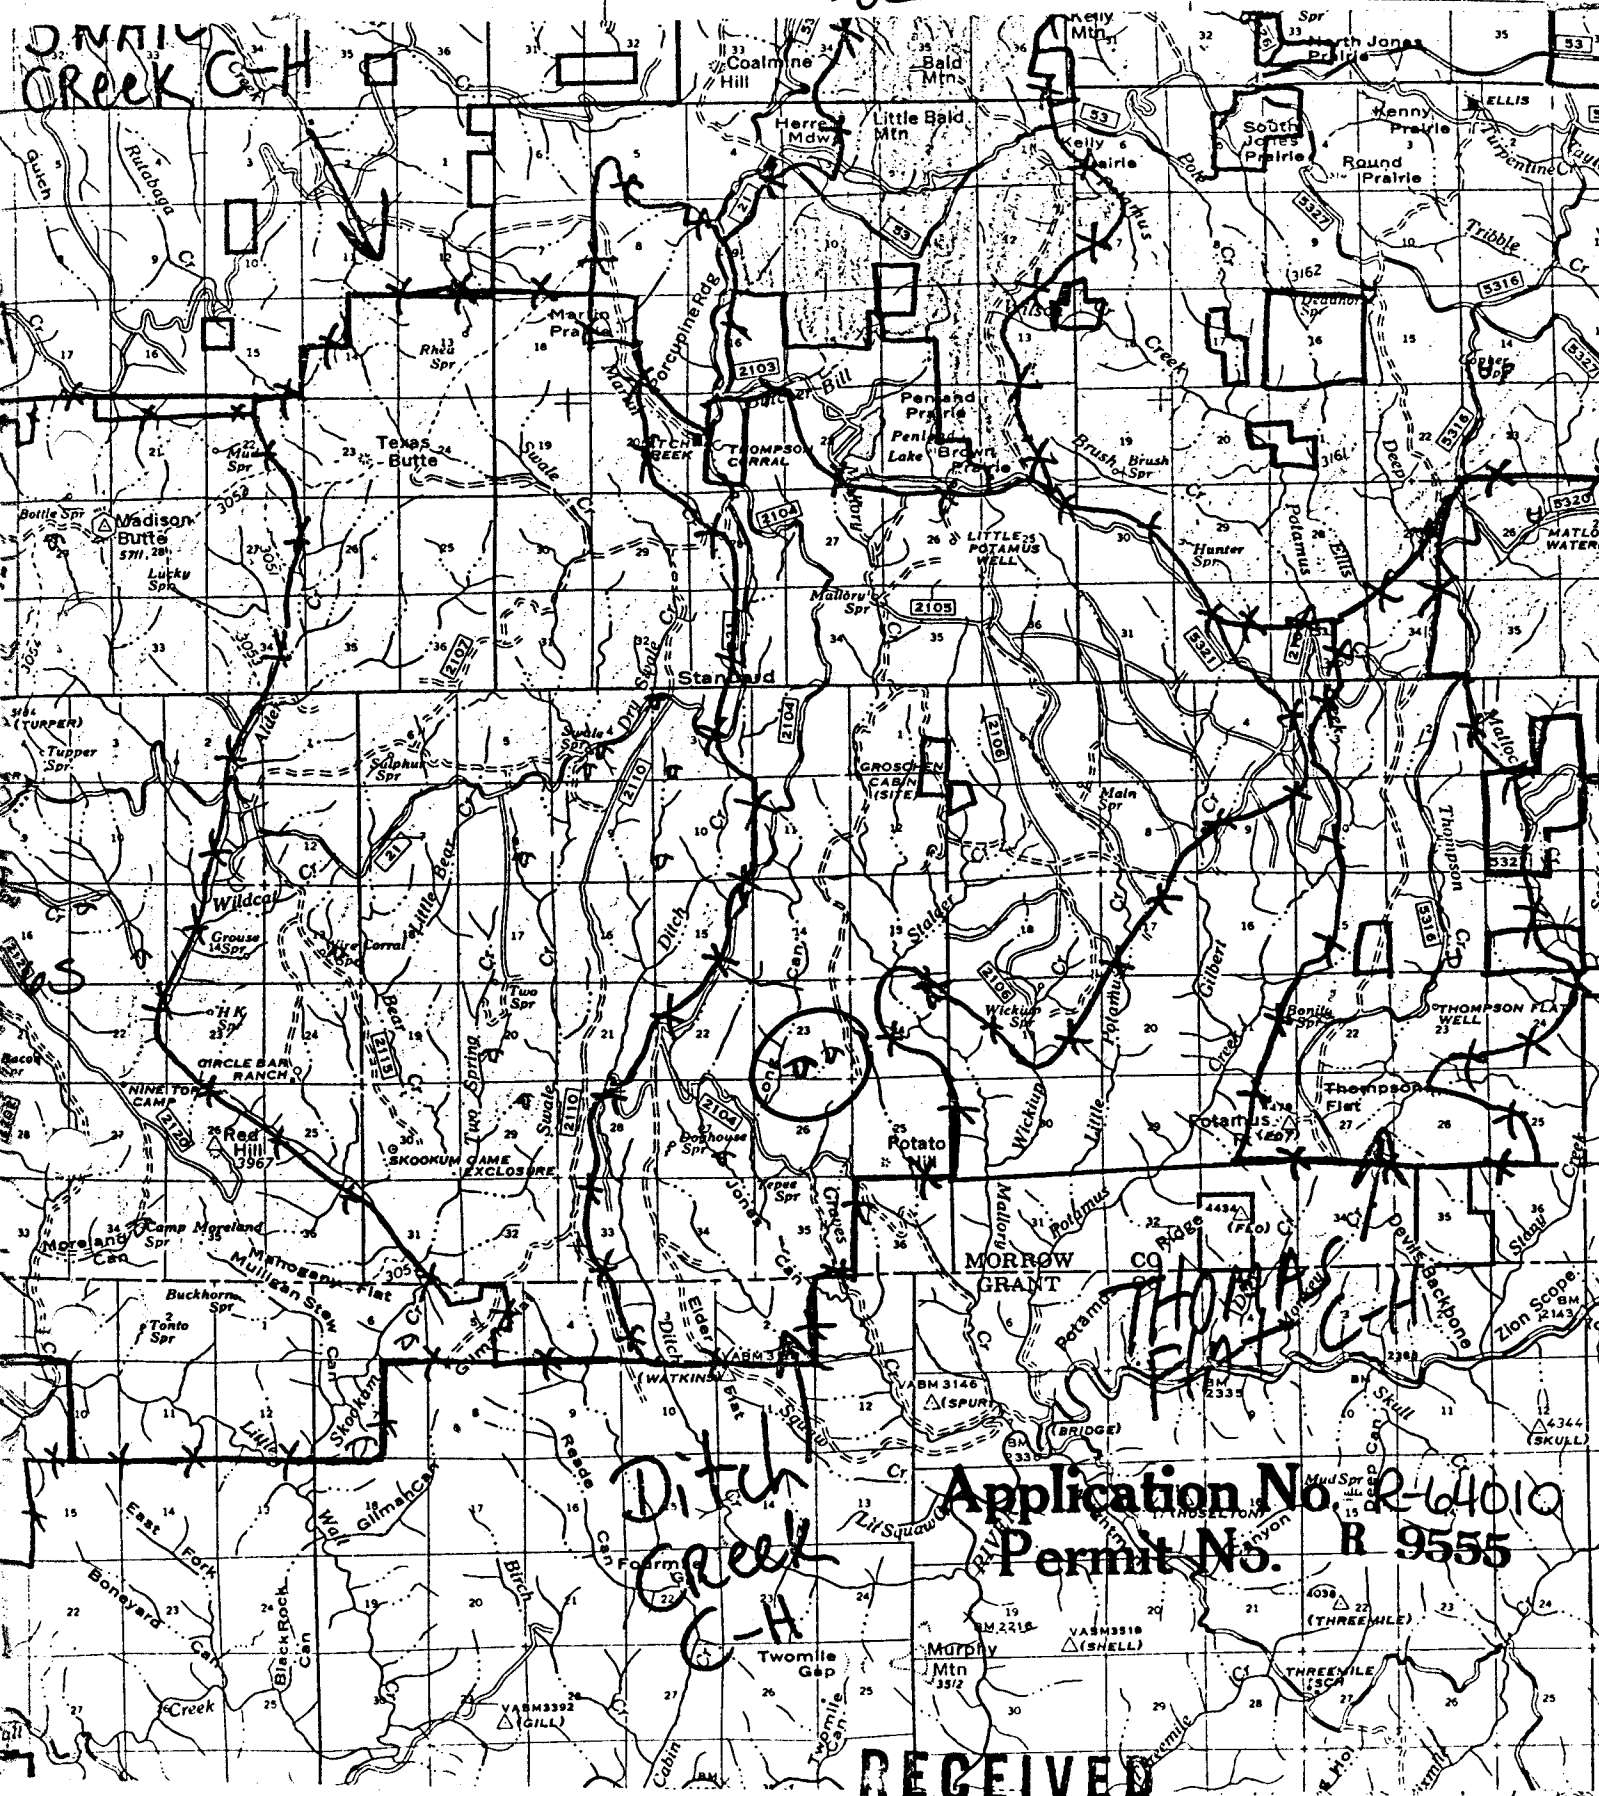

RECEIVED

AUG 30 1982

WATER RESOURCES DEPT.
SALEM, OREGON

R-9555

1 OF 2

TOWNSHIP

6 S

, RANGE

28 E

, SECTION

23

, W.M.

22

23

Application No. R-64010
Permit No. R 9555

1750'



27

26

NAME

Long Canyon Reservoir

COUNTY

Morrow

RECEIVED

AUG 30 1982

WATER RESOURCES DEPT.
SALEM, OREGON