

R-9558

61346

10FL

TOWNSHIP

7S

RANGE

25E

SECTION

15

N.M.

9

10

Application No. R-64013
Permit No. R 9558

16

1000'



15

2700'

NAME Diesel Res.


COUNTY Wheeler

RECEIVED

AUG 30 1982

WATER RESOURCES DEPT.
SALEM, OREGON

R-9558
2042

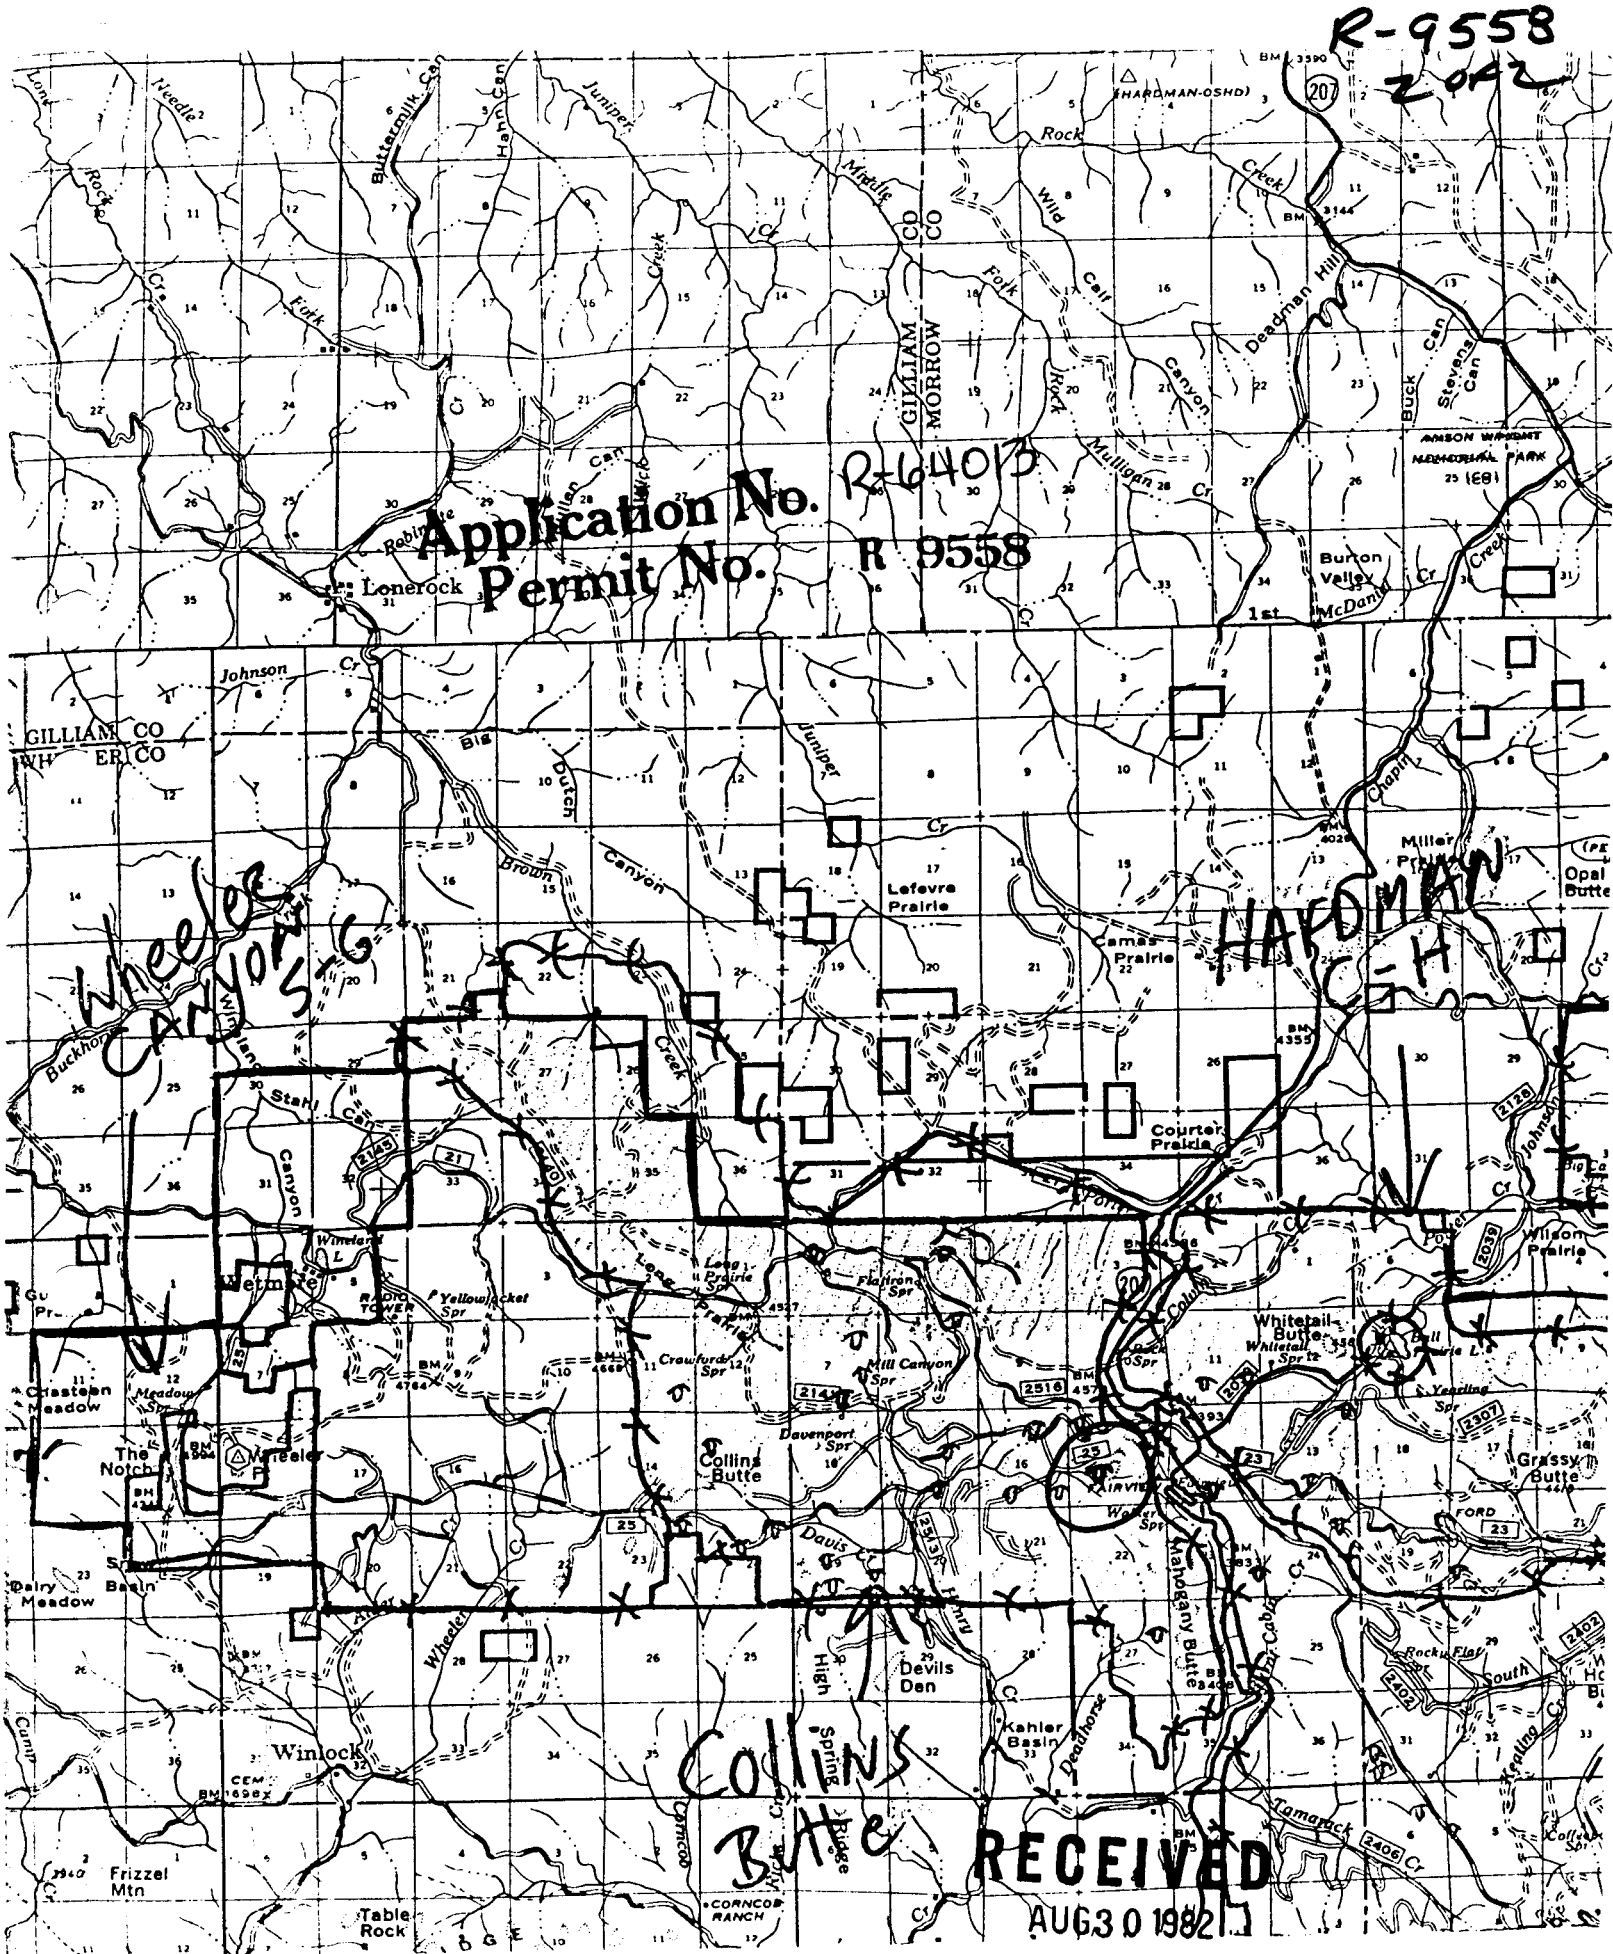

WATER RESOURCES DEPT.
SALEM, OREGON