

R-9561

10F2

N.M. 61349

TOWNSHIP

7S

RANGE

25E

SECTION

19

19

20

Application No. R-64018
Permit No. R 9561



1050'

900'

30

29

NAME

Bone Dry Pond

COUNTY

Wheeler

RECEIVED


AUG 30 1982

WATER RESOURCES DEPT.
SALEM, OREGON

R-9561

2 of 2

Application No. R-64018
Permit No. R 9561

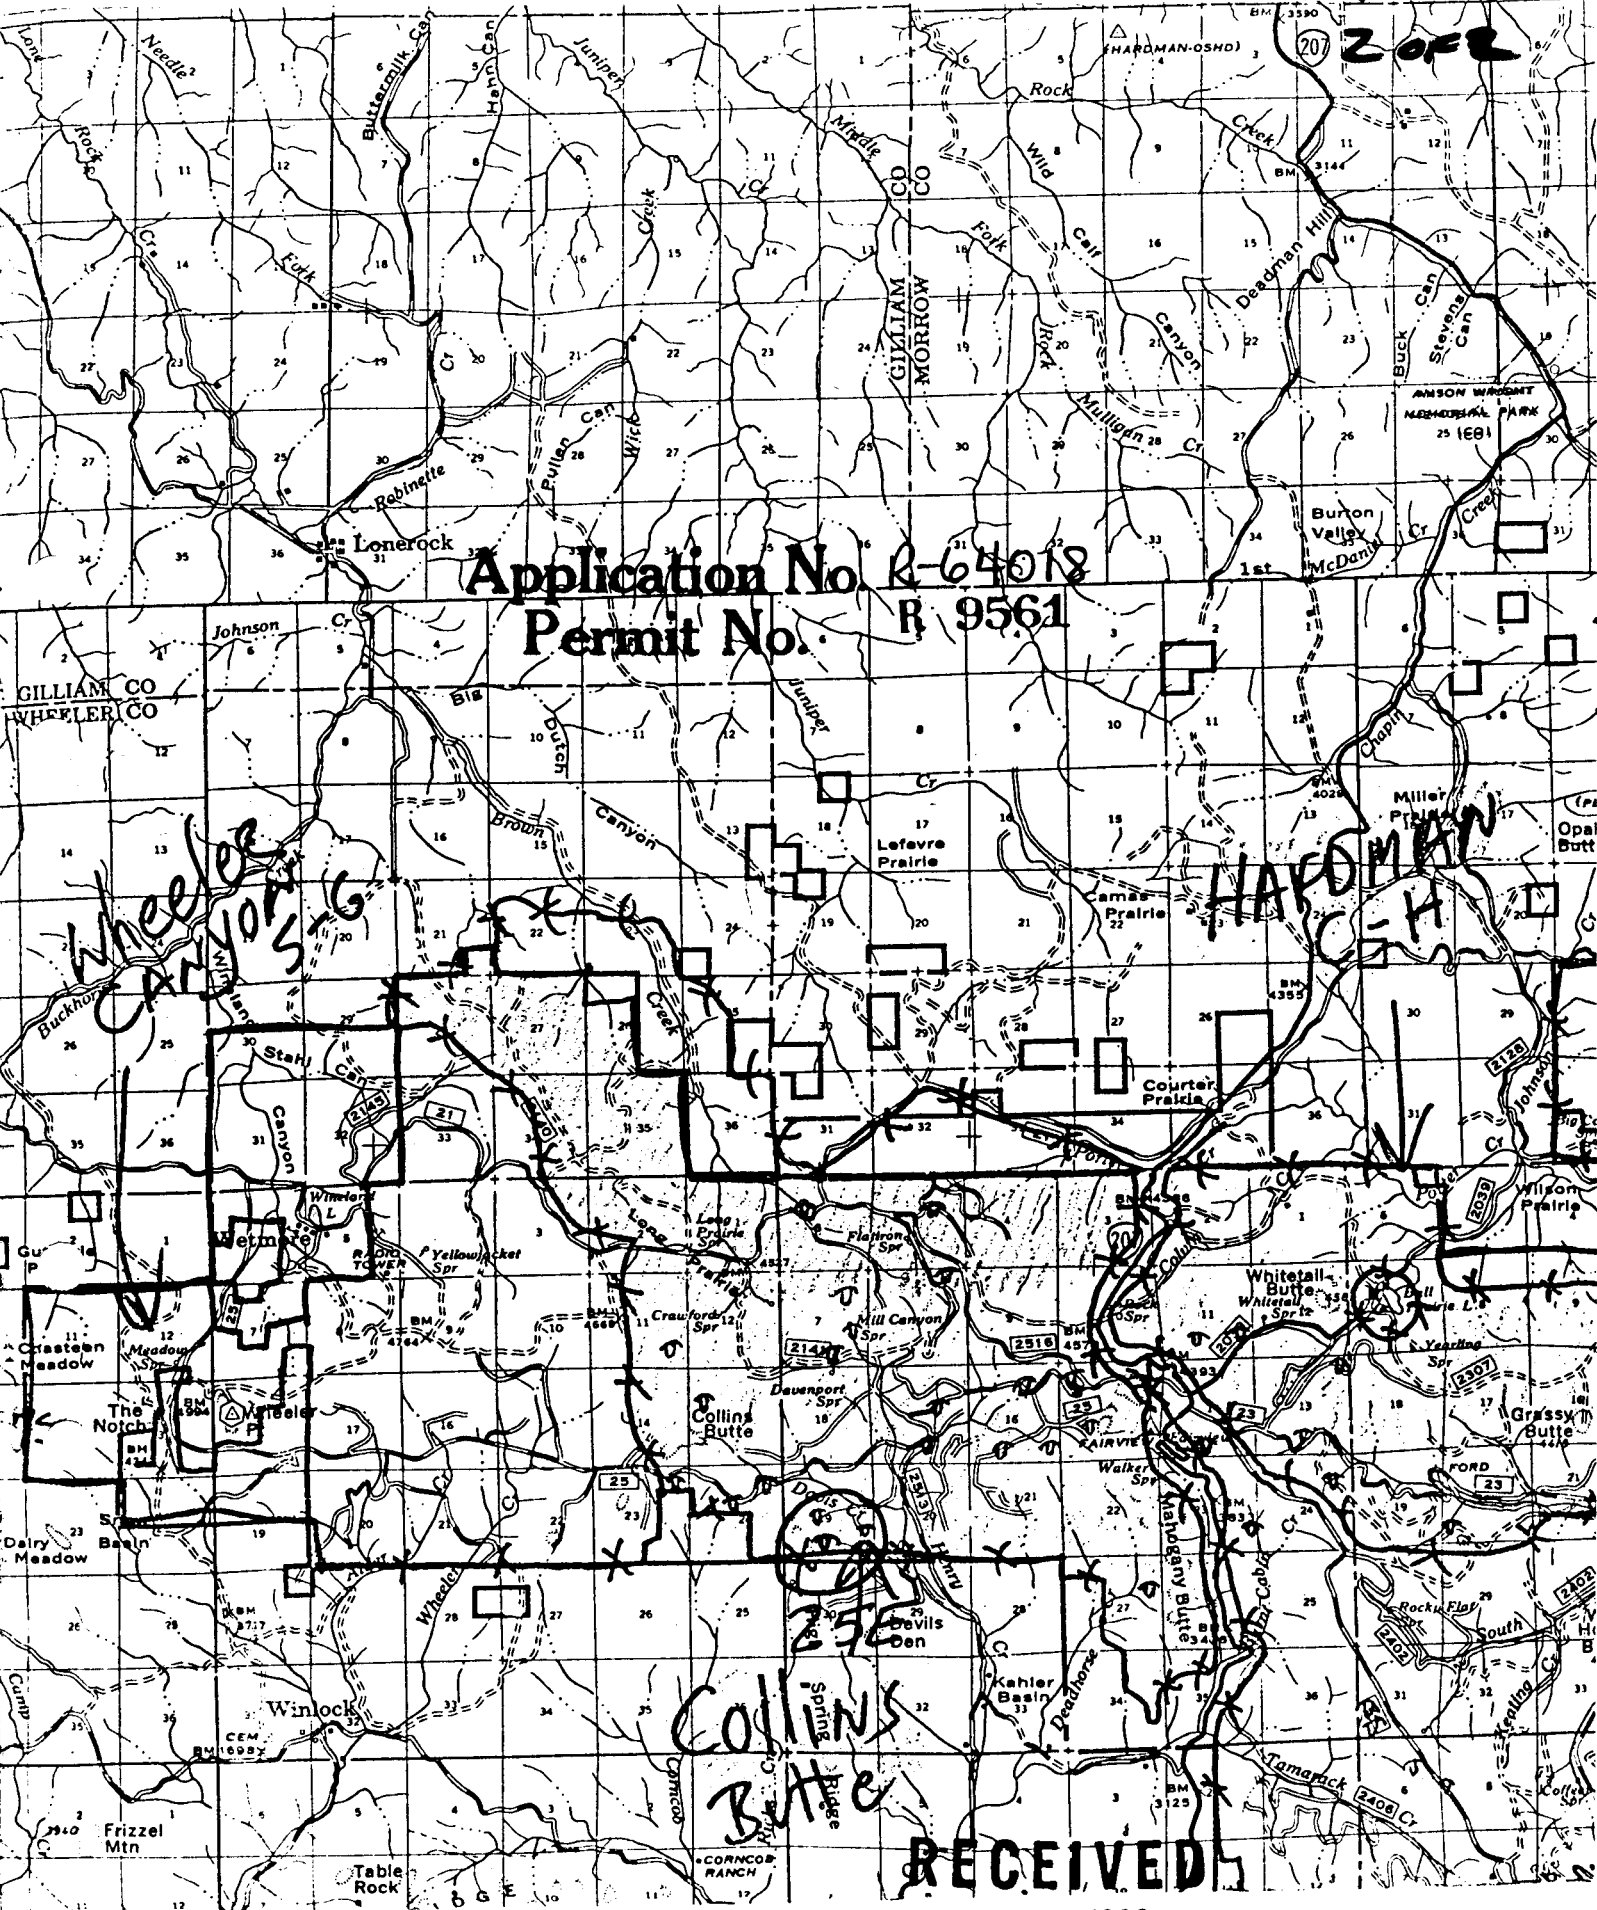

RECEIVED

AUG 30 1982

WATER RESOURCES DEPT.
SALEM, OREGON