


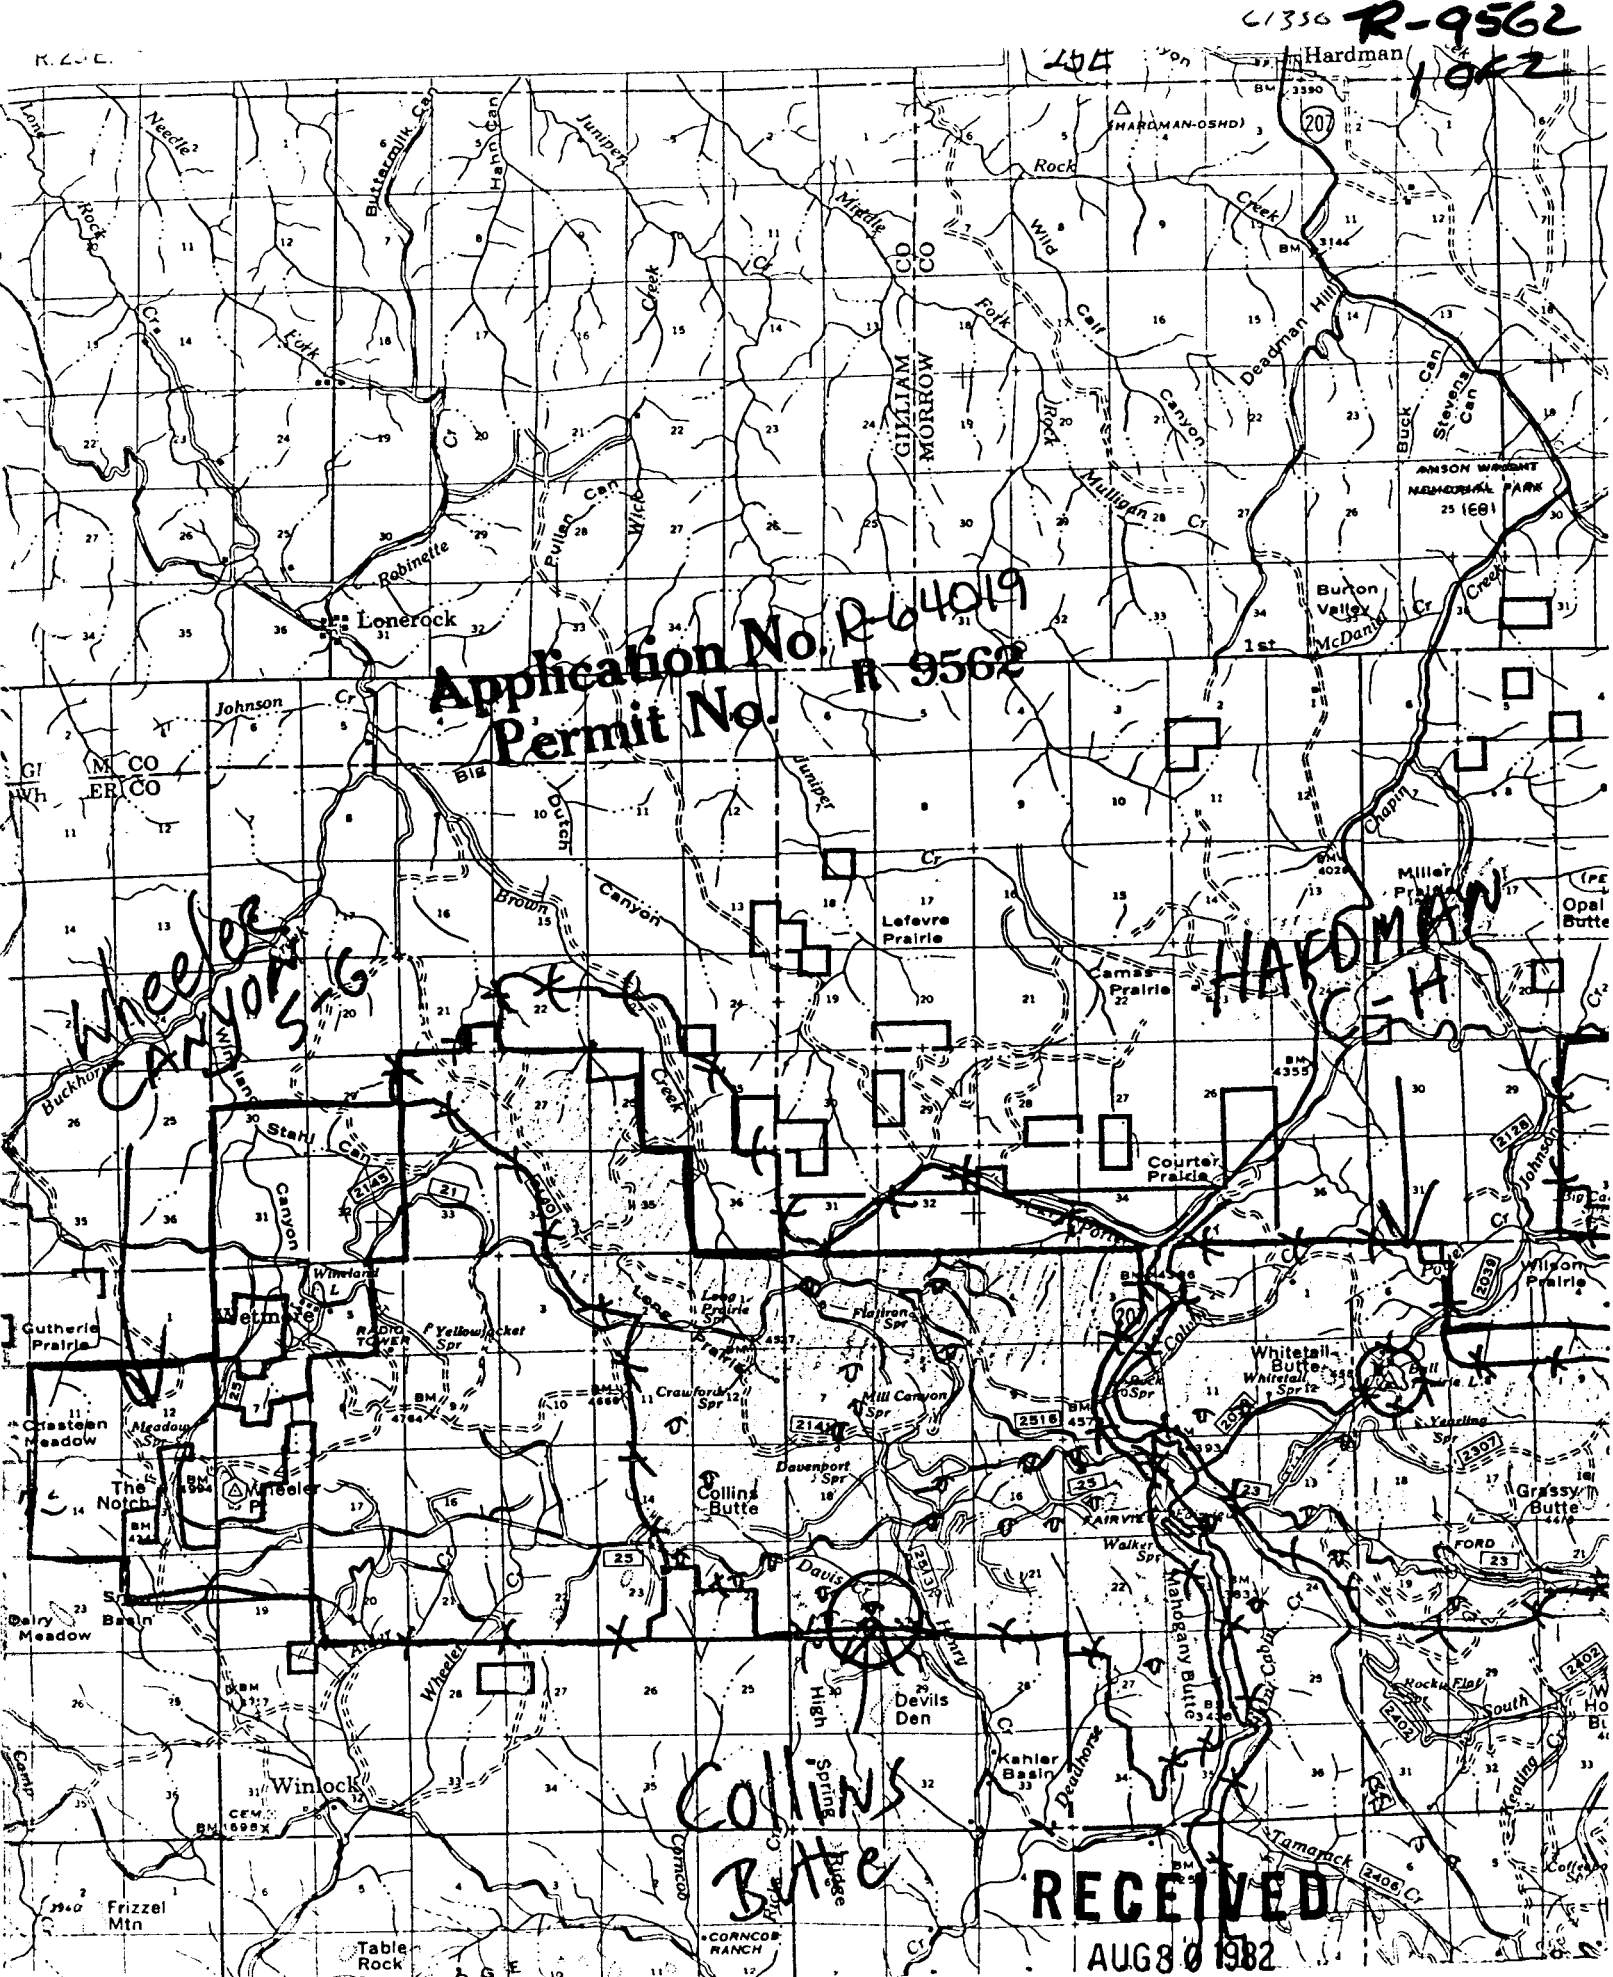

Application No. R-64019  
Permit No. R-9562

Wheeler Canyon

HARDMAN

Collins Butte

RECEIVED  
AUG 8 1982

WATER RESOURCES DEPT.  
SALEM, OREGON

R-9562  
2 of 2

TOWNSHIP 7S, RANGE 25E, SECTION 19 W.M.

19

20

1200' 200'  
ⓐ

Application No. R-64019  
Permit No. R 9562

30

29

NAME Harding Pond COUNTY Wheeler

**RECEIVED**  
AUG 30 1982  
WATER RESOURCES DEPT.  
SALEM, OREGON